


Section 14 Township Sumner 32 Range 2E
Well No. #3-A Wenrich
Company Stearns Drlg.

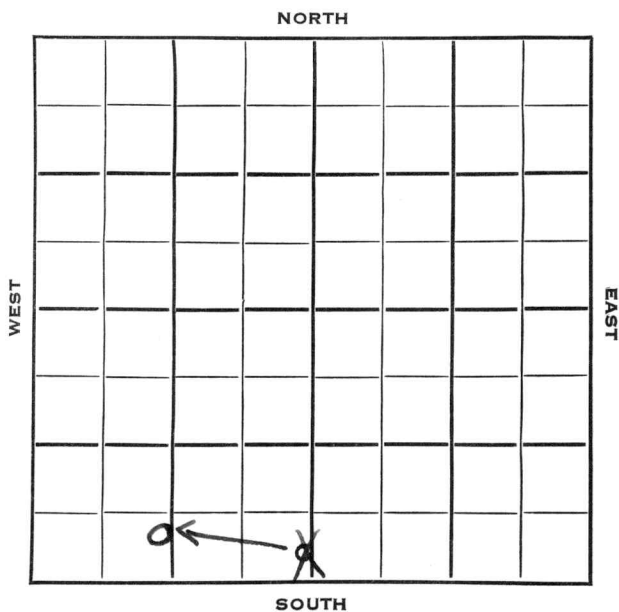

Sumner

KANSAS ✓

14

32

2E

Sec. _____ Twp. _____ R. _____

#3-A Wenrich

Well No. _____ Farm _____

Stearns Drlg.

Company _____

Stearns Drlg.

Contractor _____

Oxford Pool

_____ Ft. from N. Line

~~300~~
~~400~~


_____ Ft. from S. Line

~~50~~

_____ Ft. from E. Line

~~1250~~

_____ Ft. from W. Line

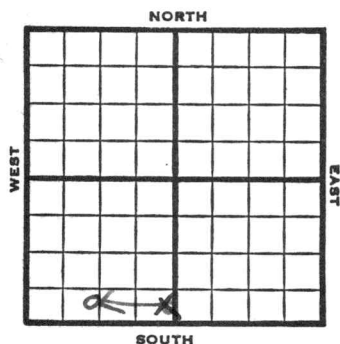~~SE SWSW~~~~SE SE SW (TWIN WELL)~~

1953

Elev. 1189' REPORT

8/19

Spud 8-15-53

10" @ 125'

Drlg. 402'

10/14

Spud 8-15-53

Oil Well

TD 2429'

10" @ 125'

Stal. 1987

DST 1175'-86' opn 1 hr, rec 120' gas,
13' oil, 415#DST 1989'-2000' opn 1 hr, rec 30' o
& gcm, 290#DST 2415'-29' opn 1 hr, rec 30' hocm
60' ocm, 870#

5" @ 2429'

TD 2429'

18/ 2416-19 4½ goph 24 gwph SP

2040 11/ 1994-2002 FU 50' oil 35'

wtr. 250" S/ 3½ bw scum oil

Layton 2416 48/ 1994-2002 frac

S/ 2½ boph 7 bw

Comp 25 bopd 75 bw.

COMPLETED

Kansas

Map No. _____ Sec. 14 Twp. 32 R. 2EWell No. 3-A Wenrich


Stearns Drlg. _____ Company

CORRECTION

Contractor _____

SE SW SW

SECTION PLAT

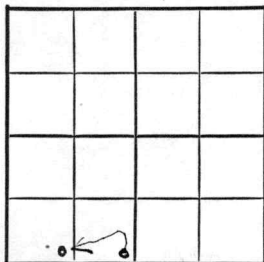

_____ Ft. from N. Line

400

_____ Ft. from S. Line

_____ Ft. from E. Line

1250

_____ Ft. from W. Line

Summer

Location _____

Rig up _____

Drilling and Remarks:

Recorrected

from

SE SE SW

RECORD

Cased _____ in., _____ ft.

Sand _____

Gas _____

Oil _____

Total Depth _____

PRODUCTION

1st 24 hrs. Nat. _____

1st 24 hrs. after shot _____

Gas _____ Cu. Ft.

Dry Hole _____

Abandoned _____

Date

AUG 26 1953 19

J. G. McGEHEE

Scout

County Sumner State Kansas

Sec. 14 (Blk. Twp.) 32 (Sur. Rge.) 2E Map No.

Operator Stearns Drlg.

Well No. 3-A Farm Wenrich

Elev.	1189	Location	SE SW SW
-------	------	----------	----------

0

400 Ft. From S Line SW

1250 Ft. From W Line Quarter

1st. Report

Completion OCT 14 1953

Remarks Oxford Pool

Stearns Drlg. - Contr.

Spudding Date 8-15-53

Drig. Data Oil well TD 2429

10" @ 125 Stal. 1987 DST 1175-86

open 1 hr. Rec. 120' gas 13' oil

415# DST 1989-2000 open 1 hr. Rec.

30' o & ocm 290# DST 2415-29 open 1 hr.

Rec. 30' hocom 60' ocm 870# 5" @ 2429

TD 2429 18/ 2416-19 $4\frac{1}{2}$ goph 24 gwph

SP 2040 11/ 1994-2002 FU 50' oil

35' wt. 250" S/ 3 $\frac{1}{2}$ bw scum oil

Layton 2416 48/ 1994-2002 frac

S/ $2\frac{1}{2}$ boph 7 bw

Comp. 25 bopd 75 bw

J. G. McGEHEE