

Sec. 25 Twp. 27 Range 8 E

3 Temple

Kansas Geological Society

Empire


Skelly Scout Tickets

Map No. _____ Sec. 25 Twp. 27 R. 8Well No. 3. Lemper FarmEmpire Gas & Fuel Co. Company660 Ft. from N. Line

_____ Ft. from S. Line

660 Ft. from E. Line

_____ Ft. from W. Line

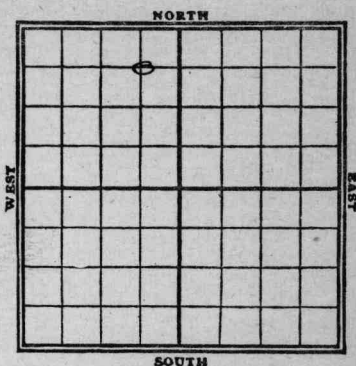

Date

REPORT FIRST REPORT

8/7 fishing 12 1/2" - 500'
11 — — —
4/27 land 1115-34 - 2,100,000 ton
Gas.

COMPLETED

Map No. 110 Sec. 25 Twp. 27 R. 8Well No. 3 TempleEmpire Company

Contractor

SECTION PLAT

660 Ft. from N. Line660 Ft. from S. Line660 Ft. from E. Line

Ft. from W. Line

	0		

FIRST REPORT

Location

Rig up

Drilling and Remarks:

fish 12' 1/2
@ 500'

RECORD

Cased _____ in., _____ ft.

Sand _____

Gas _____

Oil _____

Total Depth _____

PRODUCTION

1st 24 hrs. Nat. _____

1st 24 hrs. after shot _____

Gas _____ Cu. Ft.

Dry Hole _____

Abandoned _____

Date

2/
17 1920

Pyle

Scout

Map No. K 10 Sec. 25 Twp. 27 R. 8Well No. 3 TempleEmpire Company

Contractor


SECTION PLAT

660 Ft. from N. Line

Ft. from S. Line

660 Ft. from E. Line

Ft. from W. Line

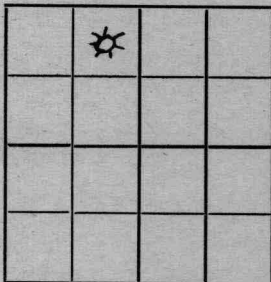

Location

Rig up

Drilling and Remarks:

RECORD

Cased _____ in. _____ ft.

Sand 1115-34

Gas _____

Oil _____

Total Depth _____

PRODUCTION

1st 24 hrs. Nat. _____

1st 24 hrs. after shot _____

Gas 2,100,000 Cu. Ft.

Dry Hole _____

Abandoned _____

Date

4/27 1920

Pyle

Scout