

DX 78-1


Sumner

KANSAS

Section 17 Township 32 Range 2 E

Well No. # 2 Owens

Company Smitherman

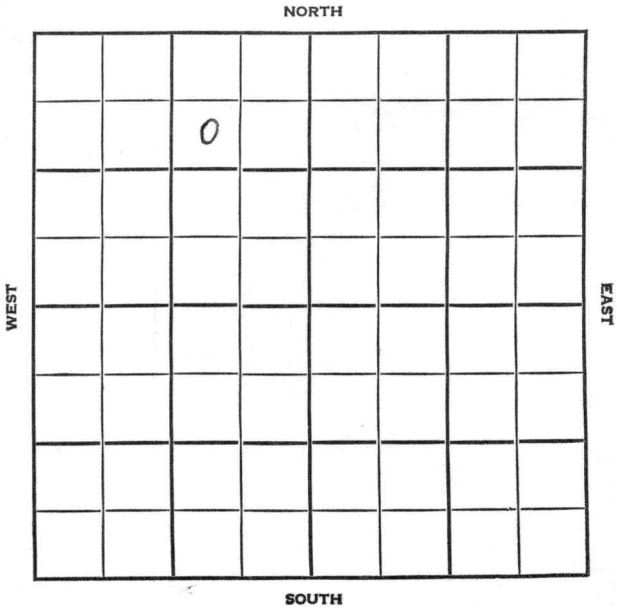

Sumner

KANSAS


SEC. 17	TWP. 32	R. 2E
------------	------------	----------

WELL NO. #2 Owens FARM

COMPANY Smitherman

CONTRACTOR Co. Tools. Miller Pool

990 Ft. from N. Line  
 \_\_\_\_\_ Ft. from S. Line  
 990 Ft. from E. Line  
 \_\_\_\_\_ Ft. from W. Line

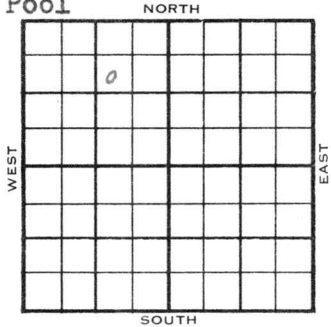

SW NE NW

1954	ELEVATION	REPORT
	1246'	
11/17	Spud 11-14-54 8" @ 115' WOC.	
12/8	Spud 11-14-54 Oil well TD 3000 8" @ 115' KC 2838 TD 3000 5" @ 2996 CO to 3000 B/4 GO 4 GW 2 hr. 100 <sup>A</sup> S/70 BO 15 BW <del>xx</del> 12 hr. Comp. 25 BOPD	

COMPLETED



