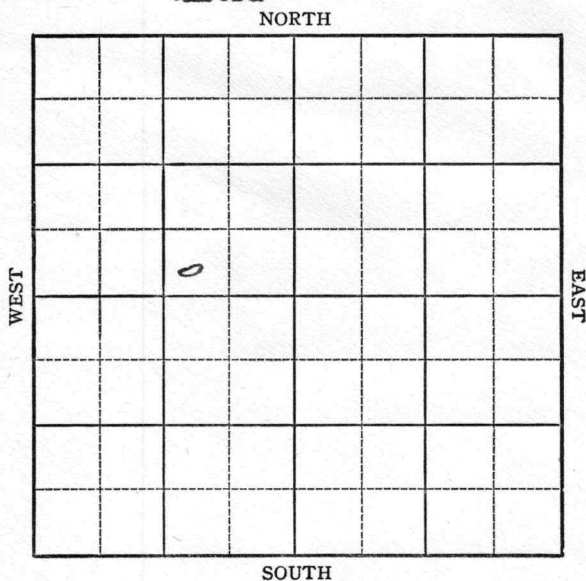


KANSAS

Summer

Section 17 Township 32 Range 2EWell No. 2 E. OwensCompany Shell
Oxford

KANSAS

Sumner

Sec. 17 Twp. 32 R. 2E

Well No. #2 E. Owens Farm

Shell

Oxford Pool (Morrison, Cont.) Company

 Ft. from N. Line

330'


 Ft. from S. Line

990'

 Ft. from E. Line

 Ft. from W. Line

SW SE NW

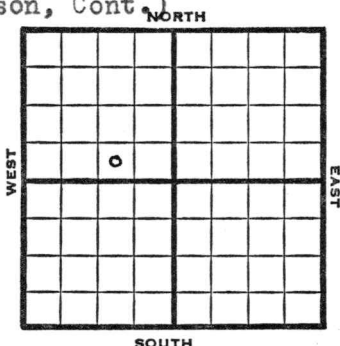

1949

lev 1230' REPORT

5/25

Spud

6/1

"

6/7

KC 2765'

Drlg 2885'

6/15

Miss 3333'

Simpson 3621'

TD 3624'

4" @ 3623'

6/21

TD 3651'

14 qts 3638-61 CO

6/28

Swb 58 bbls oil 8 hrs.

7/6

"

7/13

TD 3651'

Simp 3621'

4" @ 3623'

15 qts

Pump 101 Oil Pot

44° Gr.

Comp

COMPLETED

Map No. _____ Sec. 17 Twp. 32 R. 2E

Well No. 2 E. Owens

Shell Company

Morrison Contractor

SW SE NW

**FIRST REPORT
SECTION PLAT**

_____ Ft. from N. Line

330 Ft. from S. Line

990 Ft. from E. Line

_____ Ft. from W. Line

Sumner County

Location _____

Rig up _____

Drilling and Remarks:

Spud

RECORD

Cased _____ in., _____ ft.

Sand _____

Gas _____

Oil _____

Total Depth _____

PRODUCTION

1st 24 hrs. Nat. _____

1st 24 hrs. after shot _____

Gas _____ Cu. Ft.

Dry Hole _____

Abandoned _____

Date

MAY 25 1949 19

S. J. LEWIS Scout

Kansas

Map No. K1 Sec. 17 Twp. 32 R. 2EWell No. 2 E. Owens

Shell

Company

COMPLETE

Contractor

SW SE NW

E 1/230
SECTION PLAT

Ft. from N. Line

330

Ft. from S. Line

990

Ft. from E. Line

Ft. from W. Line

Sumner County

Location

RECORD

Cased _____ in., _____ ft.

Sand _____

Gas _____

Oil _____

Total Depth 3651

PRODUCTION

1st 24 hrs. Nat. _____

1st 24 hrs. after shot _____

Gas _____ Cu. Ft.

Dry Hole _____

Abandoned _____

Rig up

Drilling and Remarks:


Date

JUL 13 1949

19

S. J. LEWIS

Scout