

Map No. Kansas Sec. 17 Twp. 32 R. 2 E
Well No. 1 Miller Farm
Rocana & W Phillips Company
Pet Corp

NORTH

WEST

EAST

SOUTH

OWSS

Location _____

Drilling Remarks _____

Rig Up _____

Drilling Remarks _____

RECORD

Cased _____ in. _____ ft.
Sand _____
Gas _____
Oil _____
Total Depth _____

PRODUCTION

1st 24 hrs. Nat. _____
1st 24 hrs. after shot _____
Gas _____ cu. ft.
Dry Hole _____
Abandoned _____

Sumner Co

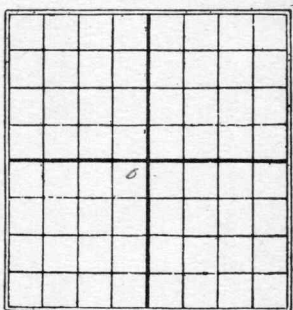
Map No. Kansas Sec. 17 Twp. 32 R. 2EWell No. 1 Miller FarmRocana & W. Phillips Company

NORTH

WEST

EAST

SOUTH

330 Ft. from N. Line

Ft. from S. Line

330 Ft. from E. Line

Ft. from W. Line

Date 1925 REPORT10/21 Location10/28 Rig on up11/411/11 drlg @ 790'11/18 " - 114719262/16 Top sand 2955 T.D. 2967
36.8 Gravity oil5/15 Top chak 3325 (OWDD)
Top line 3355Wilcox 3639 2000 fh
oil in hole (2el)1926 OWDD5/19 T.D. 3640 H.F. OilDrilling deeper5/26 T.D. 3640 fishing tools6/2 Made on 30th 195 - 31st 200
1st 180 bbls.6/9 Drly in sand 3630'6/12 Top Wilcox 36153662 Swabbed 170 bblsT.D. 3671 423 bbls 1st
12 hours (2el)

6/16 - Top Wilcot 3615

Bottom 3662' 170 bbls

Drilled Silicious Lime

T.D. 3671 652 bbls oil

36 Gravity

6/18-760 bbls averaging per day
(24)

KI *Summer*
 Map No. **KANSAS** Sec. *17* Twp. *32* R. *2E*

Well No. *1 Miller*

Rixana & H. Phillips Company

Contractor

SECTION PLAT

330 Ft. from N. Line

_____ Ft. from S. Line

330 Ft. from E. Line

_____ Ft. from W. Line

	0		

FIRST REPORTS

Location _____

Rig up _____

Drilling and Remarks:

Location.

RECORD

Cased _____ in., _____ ft.

Sand _____

Gas _____

Oil _____

Total Depth _____

PRODUCTION

1st 24 hrs. Nat. _____

1st 24 hrs. after shot _____

Gas _____ Cu. Ft.

Dry Hole _____

Abandoned _____

Date

OCT 21 1925

192

S. J. LEWIS

Scout

Map No. ~~KANSAS~~ Sec. 17 Twp. 32 R. 2E

Well No. 1 Miller

Roxana Petroleum Phillips Company

Contractor

SECTION PLAT

320 Ft. from N. Line

_____ Ft. from S. Line

330 Ft. from E. Line

_____ Ft. from W. Line

	0		

COMPLETED

Location _____

Rig up _____

Drilling and Remarks:

NO 2955

TD 2967

36.5 Gr. oil

over.

RECORD

Cased _____ in., _____ ft.

Sand _____

Gas _____

Oil _____

Total Depth _____

PRODUCTION

1st 24 hrs. Nat. _____

1st 24 hrs. after shot _____

Gas _____ Cu. Ft.

Dry Hole _____

Abandoned _____

Date

FEB 16 1926

192

S. J. LEWIS

Scout

Swatted

140 x 8 1/2 24 hrs.

175 " " 12 hrs

80 " " 12 "

60 " " 12 hrs

55 " " 12 hrs

Shd 8.209 to 2903 & 2908

Swatted

100 x 8 1/2 24 hrs.

62 " " 24 hrs

87 " " 24 "

makes 1886 water per hr.

Returned

Cards

Tracing

France Map

Scarborough Map

Moody Map

Scarborough Plat Book

Moody Plat Book

Summer
 K1 Map No. **KANSAS** Sec. *17* Twp. *32* R. *2E*

Well No. *1 Miller*

Roxana P & Co. Company

Contractor

SECTION PLAT

330 Ft. from N. Line

_____ Ft. from S. Line

330 Ft. from E. Line

_____ Ft. from W. Line

	0		

Drilling deeper.

Location *J*

Rig up _____

Drilling and Remarks:

Chad 3335

T. Line 3335

Wilcox 3637

Oil 3639

TD 3640

H. F. Oil

RECORD

Cased _____ in., _____ ft.

Sand _____

Gas _____

Oil _____

Total Depth _____

PRODUCTION

1st 24 hrs. Nat. _____

1st 24 hrs. after shot _____

Gas _____ Cu. Ft.

Dry Hole _____

Abandoned _____

Date

MAY 19 1926

S. J. LEWIS

Scout

RT Summer
 Map No. **KANSAS** Sec. *17* Twp. *32* R. *2E*

Well No. *1 Miller**Roxana Pet & W. Phillips* Company

Contractor

SECTION PLAT

330 Ft. from N. Line

Ft. from S. Line

330 Ft. from E. Line

Ft. from W. Line

	0		

COMPLETED

Location

Rig up

Drilling and Remarks:

*Top Wilcox 3615**Bottom " 3662.**170 x 8 1/2.**Drilled Silicious*
*line to 3671 TD.**652 x 8 1/2 36 9/16*

RECORD

Cased _____ in., _____ ft.

Sand _____

Gas _____

Oil _____

Total Depth _____

PRODUCTION

1st 24 hrs. Nat. _____

1st 24 hrs. after shot _____

Gas _____ Cu. Ft.

Dry Hole _____

Abandoned _____

Date

JUN 16 1926

192

S. J. LEWIS

Scout