


Map No. KANSAS Sec. 17 Twp. 32 R. 2^E
 Well No. 2-Miller Farm
Shull Pet Company

..... Ft. from N. Line
330 Ft. from S. Line
990 Ft. from E. Line
 Ft. from W. Line

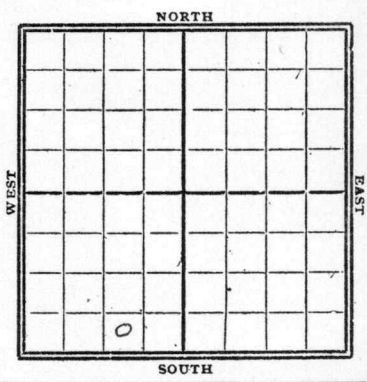

1929

Date	REPORT
6/19	cellar
6/26	Bdy tag
7/2	rig
7/10	spdy.
7/17	drly 700'
7/24	" 1410'
7/31	" 2045'
8/7	" 2792'
8/14	" 3065'
8/21	sand 3358-59 flowed 89 bbls 2 hrs 45 minutes - @ 0
8/28	
9/4	Drly 3470'
9/11	Top Simp 3664-65' drly on dry
9/18	show 3697-3704 HFW 3712-16'-SD.
9/25	T.D. 3716' Kill P.B. to 3385'
10/2	P.B. to 3385' & swab 96 bbl oil 18 hours

11019- Top Sump 3664
show 3697-3704
T.D. 3716'-HFW
P.B. to 3385'
sand 3358-59'
75 bbls oil
Comp.

Map No. **KANSAS** Sec. 17 Twp. 32 R. 2E

Well No. 2 Miller

Shell Pet. Company

Contractor

SECTION PLAT

..... Ft. from N. Line

330 Ft. from S. Line

990 Ft. from E. Line

..... Ft. from W. Line

FIRST REPORTS

Location.....

Rig up.....

Drilling and Remarks:

Cellar

RECORD

Cased..... in., ft.

Sand.....

Gas.....

Oil.....

Total Depth.....

PRODUCTION

1st 24 hrs. Nat.....

1st 24 hrs. after shot.....

Gas..... Cu. Ft.

Dry Hole.....

Abandoned.....

Date

JUN 19 1929

Scout

CHAS. L. SHERWOOD

Summer

Map No. **KANSAS** Sec. *17* Twp. *32* R. *2*

Well No. *2 Miller*

Shell Prod Co

Company

Contractor

COMPLETE

SECTION PLAT

.....Ft. from N. Line

330 Ft. from S. Line

990 Ft. from E. Line

.....Ft. from W. Line

	<i>0</i>		

Location.....

Rig up.....

Drilling and Remarks:

*Dep Simpson 3664
Shaw 3697-3704*

*Plugged back to
3385' & prod from
Sand 3358-3359'
75 Bls.*

RECORD

Cased.....in.,ft.

Sand.....

Gas.....

Oil.....

Total Depth *3716' HWL*

PRODUCTION

1st 24 hrs. Nat.....

1st 24 hrs. after shot.....

Gas.....Cu. Ft.

Dry Hole.....

Abandoned.....

Date

OCT 9 1929

CHAS. L. SHERWOOD

Scout