

KANSAS Summer

Section 17 Township 32 Range 2EWell No. 2 MillerCompany Don Ingling et al

NORTH Misc.

		6					

WEST

EAST

SOUTH

KANSAS

Summer

Sec. 17 Twp. 32 R. 2E ✓

Well No. #2 Miller Farm

Don Ingling et al Company

Miscellaneous


330' Ft. from N. Line

 Ft. from S. Line

990' Ft. from E. Line

 Ft. from W. Line

NW NE SW

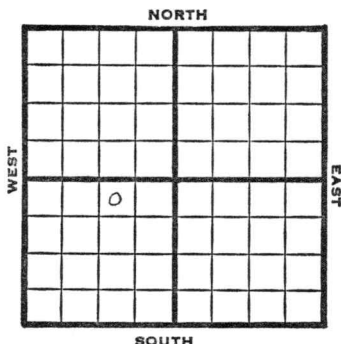

1949 ELEV ^{1220'} 1217' REPORT


3/9	Location
3/16	8" @ 78'
	Drlg. 1100'
3/23	Drlg 2562'
3/30	"
4/6	Miss 3316'
	Simpson 3619'
	TD 2624'
4/13	5" @ 3520'
	TD 3649'
	Simp 3619'
	5"@ 3620'
	Pump 50 Oil Pot
	44° gr.
	Comp

COMPLETED

Map No. _____ Sec. 17 Twp. 32 R. 2EWell No. 2 Miller_____Don Ingling et al._____
Company_____FIRST REPORT_____
Contractor

NW NE SW

SECTION PLAT

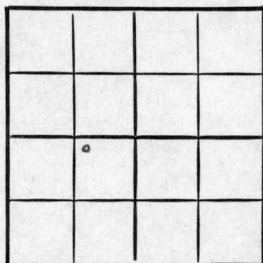330 Ft. from N. Line_____
Ft. from S. Line990 Ft. from E. Line_____
Ft. from W. LineSumner County

RECORD

Location X

Rig up _____

Drilling and Remarks:

Cased _____ in., _____ ft.

Sand _____

Gas _____

Oil _____

Total Depth _____

PRODUCTION

1st 24 hrs. Nat. _____

1st 24 hrs. after shot _____

Gas _____ Cu. Ft.

Dry Hole _____

Abandoned _____

Date

MAR 9 1949 19S. J. LEWIS Scout

Map No. _____ Sec. 17 Twp. 32 R. 2E

Well No. 2 Miller

Don Ingling etal. Company

COMPLETE

Contractor

NW NE SW

E 1,120
SECTION PLAT

330 Ft. from N. Line

_____ Ft. from S. Line

990 Ft. from E. Line

_____ Ft. from W. Line

	o		

Sumner County

Location _____

Rig up _____

Drilling and Remarks:

Dring 3619

5" C 3620

Run 5000 ft

442 ft

RECORD

Cased _____ in., _____ ft.

Sand _____

Gas _____

Oil _____

Total Depth 3649

PRODUCTION

1st 24 hrs. Nat. _____

1st 24 hrs. after shot _____

Gas _____ Cu. Ft.

Dry Hole _____

Abandoned _____

Date

APR 13 1949 19

S. J. LEWIS

Scout