


Map No. 11 Sec. 17 Twp. 32 R. 2 E

Well No. 1 Givens Farm

Roxana Pet Corp. Company

NORTH

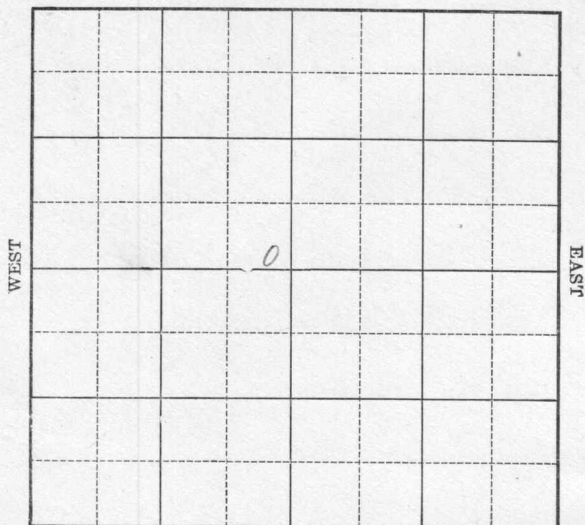

SOUTH

Location

Drilling Remarks

Rig Up

Drilling Remarks

RECORD

Cased _____ in. _____ ft.

Sand

Gas

Oil

Total Depth

PRODUCTION

1st 24 hrs. Nat.-----

1st 24 hrs. after shot -----


Gas_____cu. ft.

Dry Hole

Abandoned

Map No. Kansas Sec. 17 Twp. 32 R. 2EWell No. 1 Owens FarmRoxana Pch Company

NORTH

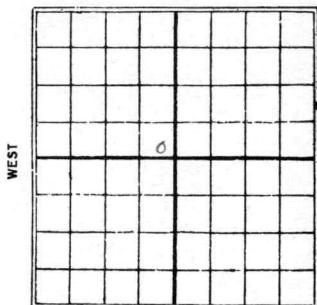

Ft. from N. Line

300 Ft. from S. Line300 Ft. from E. Line

Ft. from W. Line

REPORT

Date

1/26	
6/16	Cellar
6/23	R.O.G.
6/30	Spud
7/14	Dlg- 985
7/22	" 1595
8/7	sand 2955-65 filled up 600' 1st 7 hrs. could not bail it down
8/11	sand 2955-65-2600' oil in hole Dlg 3055
8/18	T-line 3360, show oil plg 3365
8/25	top line 3360 show oil
8/25	Dlg 3365
9/1	Bottom wilcox 3650 Drg 3370
9/8	Top wilcox 3631 oil bottom wilcox 3655 shirous line 3676 more oil, I.D. 3682 - swab 295 bbls.
9/15	C.O. & swabbing 139 bbls 15 hrs (over)

9/22 - Top Wilcox 3614
Oil 3631 - 3655 -
Sil line 3676 - 84 -
I.D. swabbed 139
bbls - 15 hrs.
shot 10 / 180 bbls
at 3677 - 3682

K1 ~~Samuel~~
 Map No. **KANSAS** Sec. 17 Twp. 32 R. 2E

Well No. 1 Owens

Roxana Prod. Corp. Company

Contractor

SECTION PLAT

-----Ft. from N. Line

300 Ft. from S. Line

300 Ft. from E. Line

-----Ft. from W. Line

FIRST REPORTS

Location -----

Rig up -----

Drilling and Remarks:

C & Har

RECORD

Cased ----- in., ----- ft.

Sand -----

Gas -----

Oil -----

Total Depth -----

PRODUCTION

1st 24 hrs. Nat. -----

1st 24 hrs. after shot -----

Gas ----- Cu. Ft.

Dry Hole -----

Abandoned -----

Date

JUN 16 1926

192

S. J. LEWIS

Scout

Map No. ANSAS Sec. 17 Twp. 32 R. 2EWell No. 1 OwensRoxana Petroleum Corp. Company

Contractor

SECTION PLAT

Ft. from N. Line

300 Ft. from S. Line300 Ft. from E. Line

Ft. from W. Line

COMPLETED

Location

Rig up

Drilling and Remarks:

Top Well core 3614Bit 3631Bottom Well core 3655Bit Line 36763684 ft. II more overswathed 139 ft10 hrs.over

RECORD

Cased _____ in., _____ ft.

Sand _____

Gas _____

Oil _____

Total Depth _____

PRODUCTION

1st 24 hrs. Nat. _____

1st 24 hrs. after shot _____

Gas _____ Cu. Ft.

Dry Hole _____

Abandoned _____

Date

SEP 22 1926

192

S. J. LEWIS Scout

shot 109 to 3677 & 3682
swatted 180 & 16.

Company

Contractor

SECTION PLAT

Pl. from N. line

Pl. from S. line

Pl. from E. line

Pl. from W. line

RECORD

Cased in _____ ft.
Sand _____
Gas _____
Oil _____
Total Depth _____

PRODUCTION

First 24 hrs. Nat. _____
Last 24 hrs. after shot _____
Gals. _____
Dry Hole _____
Abandoned _____

Returned _____
Cards *my* _____
Tracing _____
France Map _____
Scarborough Map *AB* _____
Moody Map _____
Scarborough Plat Book _____
Moody Plat Book _____