


Section 20 Township 32 Range 2E
Well No. #1 Dora Miller
Company Dunn & Strait

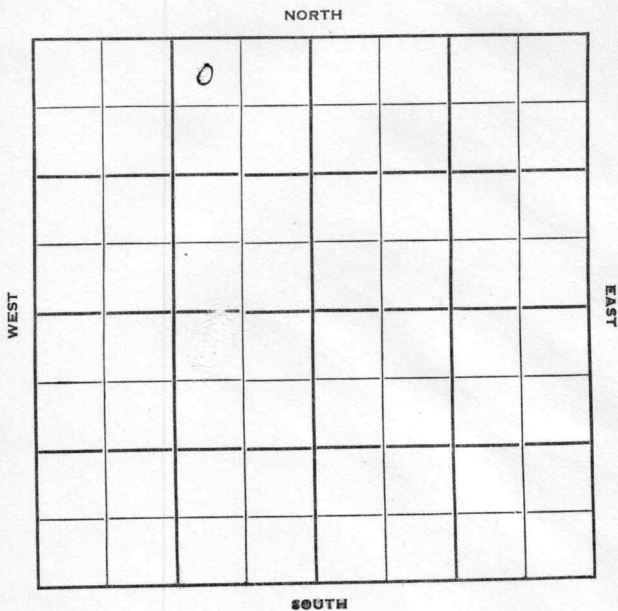

KANS.

Sumner

Sec. 20 Twp. 32 R. 2-E ✓

Well No. #1 Dora Miller Farm

Dunn & Strait Company

Morrison Drlg Contractor


330 Oxford Pool
Ft. from N. Line

Ft. from S. Line

990 Ft. from E. Line

Ft. from W. Line

NW NE NW

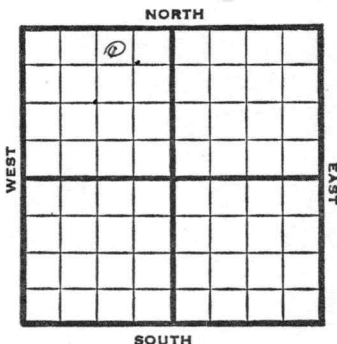

1950

Elev 1207'

REPORT

3/22

8" @ 100
Drlg 935'

4/5

TD 3390'
8" @ 100'
KC 2776'
BKC 2993'
Miss 3358'
D&A
Aband.

ABANDONED

Map No. _____ Sec. 20 Twp. 32 R. 2EWell No. 1 Dora MillerDunn & Strait CompanyMorrison Drlg. Contractor

NW NE NW

SECTION PLAT

330 Ft. from N. Line Ft. from S. Line990 Ft. from E. Line Ft. from W. Line

Sumner County

Location _____

Rig up _____

Drilling and Remarks:

8" @ 100

drlg. 935

RECORD

Cased _____ in., _____ ft.

Sand _____

Gas _____

Oil _____

Total Depth _____

PRODUCTION

1st 24 hrs. Nat. _____

1st 24 hrs. after shot _____

Gas _____ Cu. Ft.

Dry Hole _____

Abandoned _____

Date

MAR 22 1950

19

J. E. TYRA Scout

Map No. _____ Sec. 20 Twp. 32 R. 2EWell No. 1 Dora Miller

_____ Dunn & Strait _____ Company

_____ Contractor

NW NE NW

E. 1207
SECTION PLAT330 Ft. from N. Line

_____ Ft. from S. Line

990 Ft. from E. Line

_____ Ft. from W. Line

Sumner County



Location _____

Rig up _____

Drilling and Remarks:

8" @ 100
K.C. 2776
BKC 2993
Miss 3358
D & A

RECORD

Cased _____ in., _____ ft.

Sand _____

Gas _____

Oil _____

Total Depth 3390

PRODUCTION

1st 24 hrs. Nat. _____

1st 24 hrs. after shot _____

Gas _____ Cu. Ft.

Dry Hole _____

Abandoned _____

Date

APR 5 1950

19

J. E. TYRA

Scout