


Section 22 Township 32 Range 2-E

Well Number #1-Caldwell

Company Dorrance et al

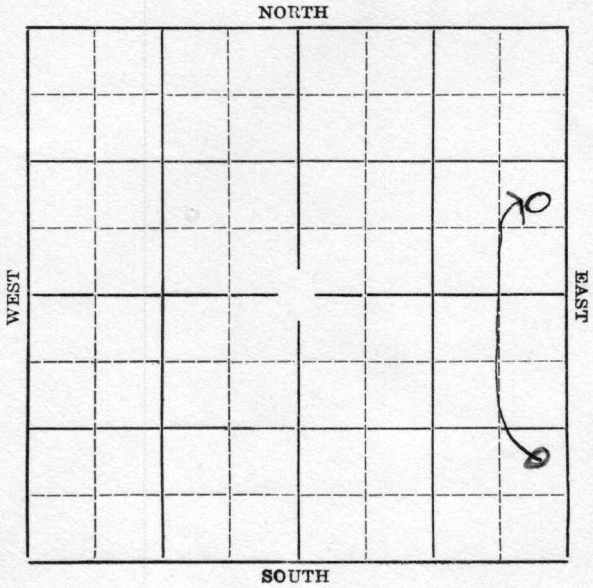

Sec. 22 Twp. 32 R. 2E


Well No. #1 Caldwell Farm  
Dorrance et al Company

\_\_\_\_\_ Ft. from N. Line

990' Ft. from S. Line

330' Ft. from E. Line

\_\_\_\_\_ Ft. from W. Line

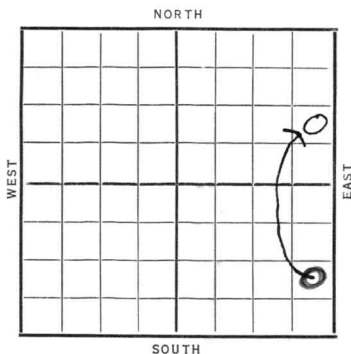

~~1936~~

REPORT

9/23 Cellar.

10/1-- 10/8-- 10/15-- 10/22-- 10/29--

11/6--- 11/12--- 11/19-- 11/27--

12/3 Rigging up

12/10 Spud.

12/17 15" @ 136'. Drlg. 470'.

12/24 Drlg. 735'.

12/29 800' underream 12".

1937

1/7 Drlg. 1362'.

1/14 8" @ 1790'. Drlg. 1825'.

1/21 6" @ 2220!. Clean out.

1/28 K.C.L. 2555'. Hole full  
 water 2580'. Drlg. 2600'.

2/4 5" @ 2680' Drlg.

2/11 5" @ 2700' Drlg.

2/17 K. C. L. 2555'.

T. D. 3065'.

H.F.W. 3065'.

ABANDONED

Map No. 1 Sec. 22 Twp. 32 R. 2E

Well No. 1 Caldwell

Torrance & Co. Company

Contractor

**SECTION PLAT**


\_\_\_\_\_ Ft. from N. Line

990 Ft. from S. Line

330 Ft. from E. Line

\_\_\_\_\_ Ft. from W. Line

**FIRST REPORT**

Location \_\_\_\_\_

Rig up \_\_\_\_\_

Drilling and Remarks:

*Caldwell*

**RECORD**

Cased \_\_\_\_\_ in., \_\_\_\_\_ ft.

Sand \_\_\_\_\_

Gas \_\_\_\_\_

Oil \_\_\_\_\_

Total Depth \_\_\_\_\_

**PRODUCTION**

1st 24 hrs. Nat. \_\_\_\_\_

1st 24 hrs. after shot \_\_\_\_\_

Gas \_\_\_\_\_ Cu. Ft.

Dry Hole \_\_\_\_\_

Abandoned \_\_\_\_\_

Date

SEP 23 1936

Kansas Pool Name Oxford

Map No. 1 Sec. 22 Twp. 32 R. 2E

Well No. 1 Caldwell

Dorrance et al Company

CORRECTION Contractor

NE SE NE

\_\_\_\_\_ Ft. from N. Line

990 Ft. from S. Line

330 Ft. from E. Line

\_\_\_\_\_ Ft. from W. Line

SECTION 'PLAT

			o 1
			X

Sumner

Location \_\_\_\_\_

Rig up \_\_\_\_\_

Drilling and Remarks:

completed  
Feb. 17, 1937  
was reported in

NE SE SE

RECORD

Cased \_\_\_\_\_ in., \_\_\_\_\_ ft.

Sand \_\_\_\_\_

Gas \_\_\_\_\_

Oil \_\_\_\_\_

Total Depth 3265

PRODUCTION

1st 24 hrs. Nat. \_\_\_\_\_

1st 24 hrs. after shot \_\_\_\_\_

Gas \_\_\_\_\_ Cu. Ft.

Dry Hole \_\_\_\_\_

Abandoned \_\_\_\_\_

Date

JUN 6 1945 19

S. J. LEWIS Scout

Map No. 1 Sec. 22 Twp. 22 R. 2E

Well No. 1 Caldwell

Torrance et al Company

Contractor

### SECTION PLAT

			o

\_\_\_\_\_ Ft. from N. Line

990 Ft. from S. Line

330 Ft. from E. Line

\_\_\_\_\_ Ft. from W. Line

ABANDONED

Location \_\_\_\_\_

Rig up \_\_\_\_\_

Drilling and Remarks:

KCL 2555

HPW 3065

### RECORD

Cased \_\_\_\_\_ in., \_\_\_\_\_ ft.

Sand \_\_\_\_\_

Gas \_\_\_\_\_

Oil \_\_\_\_\_

Total Depth 3065

### PRODUCTION

1st 24 hrs. Nat. \_\_\_\_\_

1st 24 hrs. after shot \_\_\_\_\_

Gas \_\_\_\_\_ Cu. Ft.

Dry Hole

Abandoned

Date

FEB 17 1937 19

S. J. LEWIS Scout