


Map No. KANSAS Sec. 23 Twp. 32 R. 2E
Well No. 1- Pitus Farm _____
T M Seal Company _____

NORTH

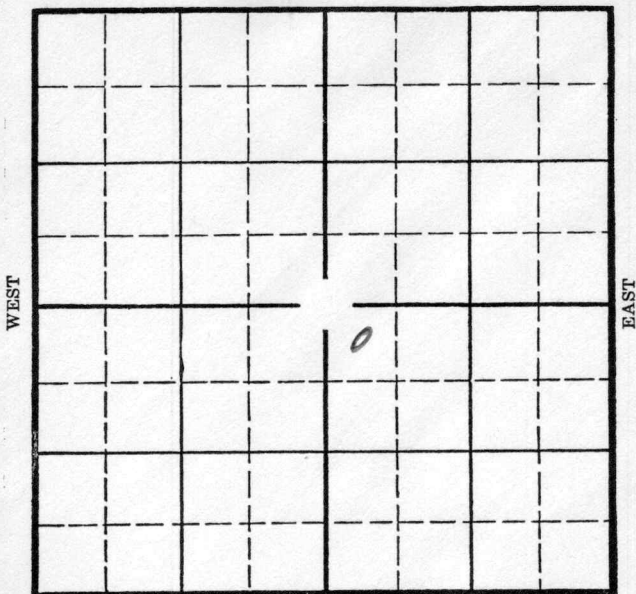

SOUTH

Location _____
Drilling Remarks _____

Rig Up _____
Drilling Remarks _____

RECORD


Cased _____ in. _____ ft.
Sand _____
Gas _____
Oil _____
Total Depth _____

PRODUCTION

1st 24 hrs. Nat. _____
1st 24 hrs. after shot _____
Gas _____ cu. ft. _____
Dry Hole _____
Abandoned _____

Map No. _____ Sec. 23 Twp. 32 R. 2E
Well No. 1- Peter Farm _____
T. M. Deal Company _____

330 Ft. from N. Line
____ Ft. from S. Line
____ Ft. from E. Line
330 Ft. from W. Line

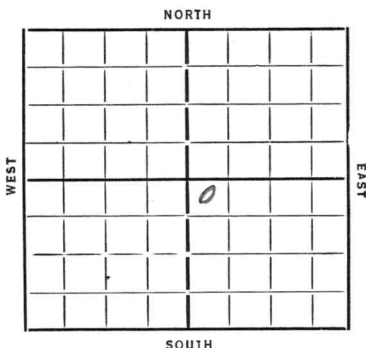

Date _____ REPORT

1925
11/6 Moving In
11/14 Bk
11/21 Ru
11/29 dly 474 12" 252
12/6 Stab 2245 No Show
dly 2400
12/13 Top Layton 2660
TKC 2676
BK 2868
dly 3090
12/19 3454
12/26 Top Miss 3195
Top Simp 3514- 7" 3514
TD 3519 Rust
12/26 SD
1/10 Rust
1/17
1/24 Wtr 3530-35
dly 3541
1/31 TD 3546 will AB to Layton
2/7 AB
2/4 — 2/21—

OVER

2/28 SD.

3/18 Simpson 3514
TD 3546

Dr A

ABANDONED

Map No. 1 Sec. 23 Twp. 32 R. 23Well No. 1-PeterT.M. Neal Company

Contractor

FIRST REPORTS

SECTION PLAT

330 Ft. from N. Line

Ft. from S. Line

Ft. from E. Line

330 Ft. from W. Line

		0	

Location

Rig up

Drilling and Remarks:

moving in

RECORD

Cased in., ft.

Sand

Gas

Oil

Total Depth

PRODUCTION

1st 24 hrs. Nat.

1st 24 hrs. after shot

Gas Cu. Ft.

Dry Hole

Abandoned

Date

ORVAL MANNSCHRECK

11-6-35 192

Scout

Orval:

We show Washoma Pet.
well located sec. 23-32-2E
In NW SE
330 feet N. line
330 feet W. Line

Check and advise
Sam

Returned	<i>CP</i>
Cards	<i>Go</i>
Tracing	<i>Go</i>
France Map	<i>Go</i>
Scarborough Map	<i>Go</i>
Moody Map	<i>Go</i>
Scarborough Plat Book	<i>Go</i>
Moody Plat Book	<i>Go</i>

Map No. 1 Sec. 22 Twp. 32 R. 2E

Well No. 1 - Peter

T. M. Deal Company

Contractor

COMPLETED

SECTION PLAT

330 Ft. from N. Line

..... Ft. from S. Line

..... Ft. from E. Line

330 Ft. from W. Line

		0	

Location.....

Rig up.....

Drilling and Remarks:

L. & A.

RECORD

Cased..... in., ft.

Sand Simpson 3514

Gas.....

Oil.....

Total Depth 3546

PRODUCTION

1st 24 hrs. Nat.....

1st 24 hrs. after shot.....

Gas..... Cu. Ft.

Dry Hole.....

Abandoned.....

Date

MAR 18 1936 192..... Scout

ORVAL MANNSCHRECK