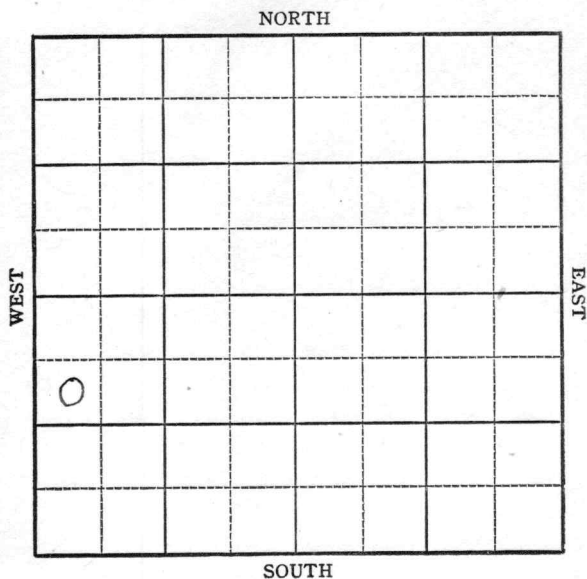


KANSAS Summer

Section 23 Township 32 Range 2EWell No. 2 "A" WenrichCompany Slocumb & Jarvis

Sec. 23 Twp. 32 R. 2-E

Well No. #2 "A" Wenrich (twin) Farm

Slocumb & Jarvis Company
Sumner


990 Ft. from N. Line

 Ft. from S. Line

 Ft. from E. Line

480 Ft. from W. Line

SW NW SW

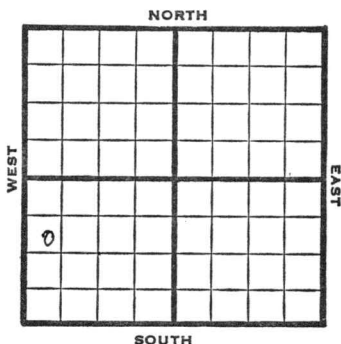

1948

Eli 1195'

REPORT

8/11

8" @ 107'

Drlg 200'

8/18

Stolmacker 2045

TD 2122'

5" @ 2122'

8/25 5

TD 2126 HFW

PB 2120'

30 qts 1930-44 Co

9/1

Hoover 1930'

5" @ 2122'

TD 2126'

Pump 100 oil Pot

40° Gr.

Comp

COMPLETED

Sumner County Kansas State

Map No. _____ Sec. 23 Twp. 32 R. 2E

Well No. 2 "A" Wenrich

Slocumb & Jarvis Company

FIRST REPORT

Contractor

SW NW SW

SECTION PLAT

990 Ft. from N. Line

_____ Ft. from S. Line

_____ Ft. from E. Line

480 Ft. from W. Line

Sumner County

Remarks:

twin well 8" @ 107' drlg. 200

Misc. Small Pipes
Cords
Tracing
France 1.00
Scarborough 1.00
Fierce 1.00
Geological 1.00
Pierce 1.00

Date
AUG 11 1948

Scout **S. J. LEWIS**

Summer County Kansas State

Map No. 1 Sec. 23 Twp. 32 R. 2E

Well No. 2 "A" Wenrich

Slocumb & Jarvis Company

COMPLETE

Contractor

SW NW SW

E. 11/95
SECTION PLAT

990 Ft. from N. Line

 Ft. from S. Line

 Ft. from E. Line

480 Ft. from W. Line

Miscellaneous

Remarks:

Hoover 1930

5" C2/22

YTD 2/26

Run 100 oil to X

40° SW

Date
SEP 1 1948

Scout S. J. LEWIS