

Map No. _____ Sec. 23 Twp. 32 R. 2E
Well No. 5-Wenrich Farm
Palmer & Barnsdall Company

WEST

EAST

SOUTH

Drilling Remarks

Drilling Remarks

RECORD

Cased.....in.ft.

Sand

Gas

Oil _____

Total Depth.....

PRODUCTION

1st 24 hrs. Nat.....

1st 24 hrs. after shot.....

Gas..... cu. ft.

Dry Hole

Abandoned

KANSAS

Map No. _____ Sec. 23 Twp. 32 R. 2 EWell No. 5-Wenrick Farm
Palmer & Barnsdall Company

NORTH

220 Ft. from N. Line

_____ Ft. from S. Line

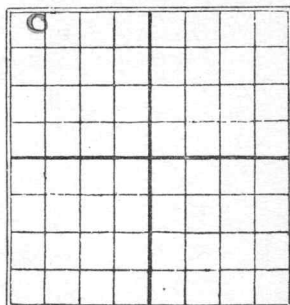
_____ Ft. from E. Line

645 Ft. from W. Line

WEST

EAST

SOUTH

1928

Date

REPORT

3/14 Location
3/21 Bldg rig
3/28 spud
4/4 Drilg 675
4/11 " 1695
4/18 T.S. 2032 T.D. 2125
170/2040-2120
swabbed & flowed
985 bbls 24 hrs

Map No. **KANSAS** Sec. 23 Twp. 22 R. 2E

Well No. 5 Henrich

Palmer & Barnsclaff Company

Contractor

SECTION PLAT

o			

220 Ft. from N. Line

_____ Ft. from S. Line

_____ Ft. from E. Line

645 Ft. from W. Line

FIRST REPORTS

Location ✓

Rig up _____

Drilling and Remarks:

RECORD

Cased _____ in., _____ ft.

Sand _____

Gas _____

Oil _____

Total Depth _____

PRODUCTION

1st 24 hrs. Nat. _____

1st 24 hrs. after shot _____

Gas _____ Cu. Ft.

Dry Hole _____

Abandoned _____

Date

MAR 14 1928

192

S. J. LEWIS

Scout

Map No. **KANSAS** Sec. 23 Twp. 32 R. 2EWell No. 5 HensickPalmer & Barnsdall Company

Contractor

SECTION PLAT

220 Ft. from N. Line

Ft. from S. Line

Ft. from E. Line

645 Ft. from W. Line

0			

COMPLETED

Location

Rig up

Drilling and Remarks:

T.S. 2032T.D. 2125170/2040-2120Swabbed by Lloyd985886 24 hrs

RECORD

Cased _____ in., _____ ft.

Sand _____

Gas _____

Oil _____

Total Depth _____

PRODUCTION

1st 24 hrs. Nat. _____

1st 24 hrs. after shot _____

Gas _____ Cu. Ft.

Dry Hole _____

Abandoned _____

Date

APR 18 1928S. J. LEWIS

Scout