


Map No. KANSAS Sec. 23 Twp. 32 R. 2E
 Well No. 8 Wenrich Farm
Palmer + Barnsdall Company

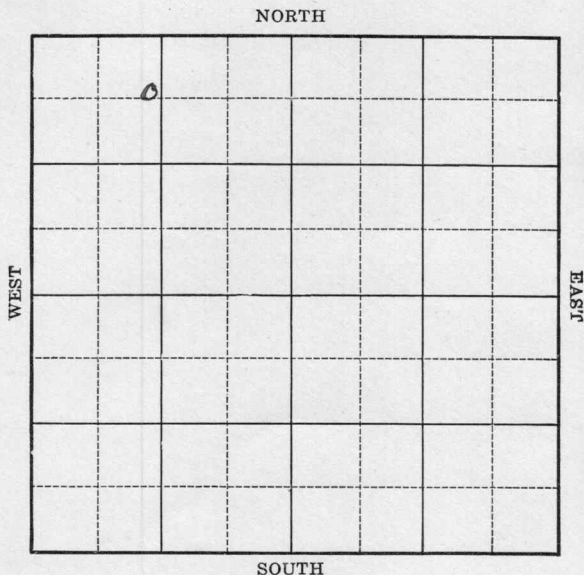

Location _____

Drilling Remarks _____

RECORD

Cased _____ in. _____ ft.

Sand _____

Gas _____

Oil _____

Total Depth _____

Rig Up _____

Drilling Remarks _____

PRODUCTION

1st 24 hrs. Nat. _____

1st 24 hrs. after shot _____

Gas _____ cu. ft.

Dry Hole _____

Abandoned _____

KANSAS

Map No. _____ Sec. 23 Twp. 32 R. 25


Well No. 8 - Wenrich Farm
Palmer + Barnsdall Company

641 Ft. from N. Line

_____ Ft. from S. Line

_____ Ft. from E. Line

1071 Ft. from W. Line

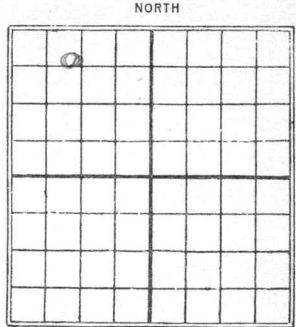

1928

Date

REPORT

4/25	Bldg Rig
5/2	Rigging up-
5/9	Drlg—350
5/16	" 1205
5/23	" 1990
5/31	Top Stalnacker 2023
	T.D. 2100 in sand
	shot 240 gti
	swabbing 125 bbb

Map No. **KANSAS** Sec. 23 Twp. 32 R. 24

Well No. J. Henrich

Palmer & Barusolab Company

Contractor

SECTION PLAT

0			

641 Ft. from N. Line

_____ Ft. from S. Line

_____ Ft. from E. Line

1071 Ft. from W. Line

FIRST REPORTS

Location _____

Rig up _____

Drilling and Remarks:

Building rig

RECORD

Cased _____ in., _____ ft.

Sand _____

Gas _____

Oil _____

Total Depth _____

PRODUCTION

1st 24 hrs. Nat. _____

1st 24 hrs. after shot _____

Gas _____ Cu. Ft.

Dry Hole _____

Abandoned _____

Date

APR 25 1928

192

S. J. LEWIS

Scout

Map No. KANSAS Sec. 23 Twp. 82 R. 25

Well No. T. Henrich

Palmer & Barnsdall Company

Contractor

SECTION PLAT

0			

641 Ft. from N. Line

_____ Ft. from S. Line

_____ Ft. from E. Line

1071 Ft. from W. Line

COMPLETED

Location _____

Rig up _____

Drilling and Remarks:

Top. Stalnacker

Sand 2023

Top depth in sand

2180

Shot 2409 to 2348

2095

Swapping 2588

Date

RECORD

Cased _____ in., _____ ft.

Sand _____

Gas _____

Oil _____

Total Depth _____

PRODUCTION

1st 24 hrs. Nat. _____

1st 24 hrs. after shot _____

Gas _____ Cu. Ft.

Dry Hole _____

Abandoned _____

MAY 31 1928

S. J. LEWIS Scout