


Map No. KANSAS Sec. 23 Twp. 32 R. 2E

Well No. 10 - Wenrick Farm
Palmer & Barnsdall Company

NORTH

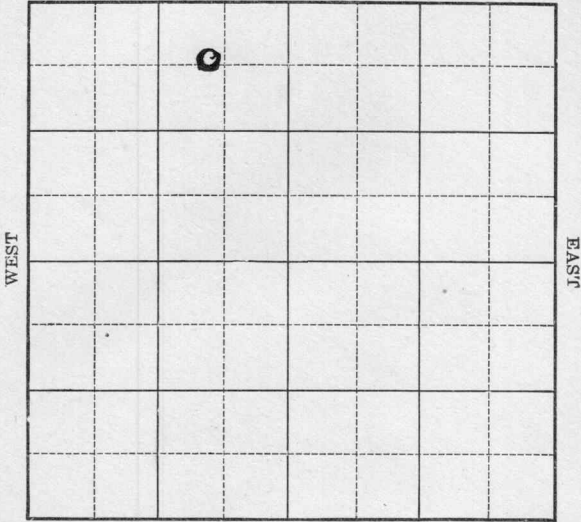

SOUTH

Location _____

Drilling Remarks _____

Rig Up _____

Drilling Remarks _____

RECORD

Cased _____ in. _____ ft.

Sand _____

Gas _____

Oil _____

Total Depth _____

PRODUCTION

1st 24 hrs. Nat. _____

1st 24 hrs. after shot _____

Gas _____ cu. ft.

Dry Hole _____

Abandoned _____

Map No. KANSAS Sec. 23 Twp. 32 R. 25

Well No. 10 Henrik

Palmer & Barnsdall Company

Contractor

SECTION PLAT

664 Ft. from N. Line

----- Ft. from S. Line

703 Ft. from E. Line

----- Ft. from W. Line

	0		

FIRST REPORTS

Location -----

Rig up -----

Drilling and Remarks:

Rig

RECORD

Cased ----- in., ----- ft.

Sand -----

Gas -----

Oil -----

Total Depth -----

PRODUCTION

1st 24 hrs. Nat. -----

1st 24 hrs. after shot -----

Gas ----- Cu. Ft.

Dry Hole -----

Abandoned -----

Date

JUL 1 1928

192

S. J. LEWIS

Scout

MAP NO. KANSAS SEC. 23 TWP. 22 R. 2E

WELL NO. 10 Kendrick

Palmer & Barnsdall COMPANY

CONTRACTOR

SECTION PLAT

	0		

664 FT. FROM N. LINE

FT. FROM S. LINE

703 FT. FROM E. LINE

FT. FROM W. LINE

COMPLETED

LOCATION _____

RIG UP _____

DRILLING AND REMARKS:

Sand 1989
Total depth to 2108
Surf 409 to 1995
2106
Graveling 305 ft

RECORD

CASED _____ IN., _____ FT.

SAND _____

GAS _____

OIL _____

TOTAL DEPTH _____

PRODUCTION

1ST 24 HRS. NAT. _____

1ST 24 HRS. AFTER SHOT _____

GAS _____ CU. FT.

DRY HOLE

ABANDONED _____

DATE

AUG 15 1928 192

S. J. LEWIS SCOUT