


Section 23 Township 32 Range 2-E
Well No. #19 Wenrich
Company Lario Oil & Gas

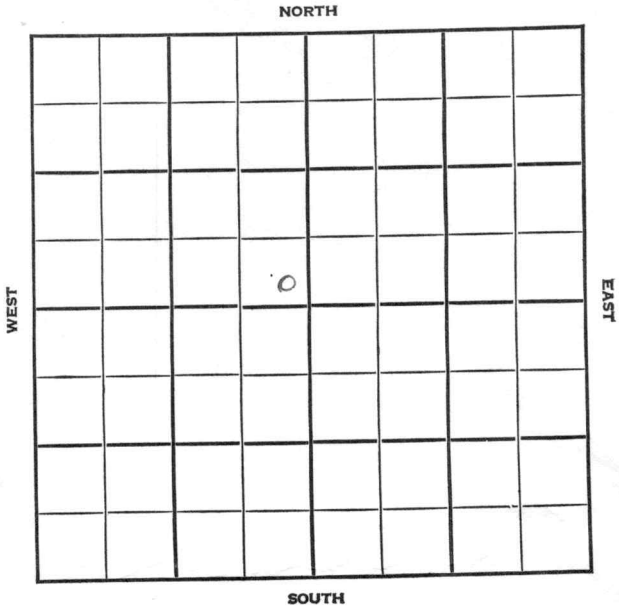

KANSAS

Summer

Sec. 23 Twp. 32 R. 2E

Well No. #19 Wenrich Farm

Lario Oil & Gas Company

Miscellaneous


 Ft. from N. Line

220' Ft. from S. Line

244' Ft. from E. Line

 Ft. from W. Line

SE NW

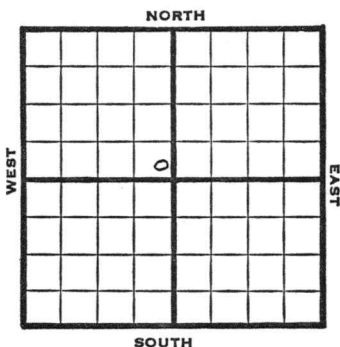

1948

Eli

REPORT

7/14 8" @ 310'
1625' fsg.
7/21 Stalnacher 2007-2021'
TD 2021
5"@ 2007'
7/28 TD 2060'
40 qts 2014-55
CO
8/4 Stal 2007'
5"@ 2007'
TD 2060'
40 qts 2014-55'
Pump 100' oil / 30 W Pot
40° Gr.
Comp

COMPLETED

Map No. _____ Sec. 23 Twp. 32 R. 2E

Well No. 19 Wenrich

Lario Oil & Gas

Company

FIRST REPORT

Contractor

SE NW

SECTION PLAT

_____ Ft. from N. Line

220 Ft. from S. Line

244 Ft. from E. Line

_____ Ft. from W. Line

Sumner County

Location _____

Rig up _____

Drilling and Remarks:

8" @ 310

1625 fsg.

RECORD

Cased _____ in., _____ ft.

Sand _____

Gas _____

Oil _____

Total Depth _____

PRODUCTION

1st 24 hrs. Nat. _____

1st 24 hrs. after shot _____

Gas _____ Cu. Ft.

Dry Hole _____

Abandoned _____

Date

JUL 14 1948 19

S. J. LEWIS Scout

Sumner County Kansas State

Map No. 1 Sec. 23 Twp. 32 R. 2E

Well No. 19 Wenrich

Lario Oil & Ref. Company

COMPLETE

Contractor

SE NW

SECTION PLAT

Ft. from N. Line

220 Ft. from S. Line

244 Ft. from E. Line

Ft. from W. Line

Miscellaneous

Remarks:

Stal 2007

5' 10" 2007

40 2060

40 2014-55

Pump 100 oil + 30 NW 8

40 2 2

Date
AUG 4 1948

Scout S. J. LEWIS