
FORM 51 25M 8-50 WESTERN Sumner KANSAS

Section 23 Township 32 Range 2E

Well No. #20 Wenrich

Company Sunray & Lario

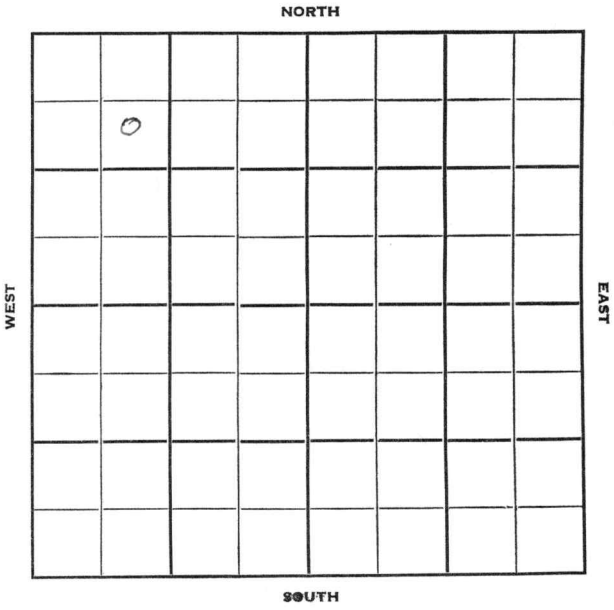

FORM 252-B
10M 10-50 PETROL

Sumner KANSAS

Sec. 23 Twp. 32 R. 2E

Well No. #20 Wenrick Farm

Sunray & Lario Company

Martin & Cash - Contr. Contractor

Oxford Pool


825' Ft. from N. Line

Ft. from S. Line

Ft. from E. Line

990' Ft. from W. Line

C E L SE NW NW

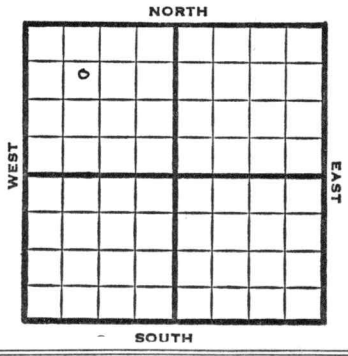

1950	Elev 1182' REPORT
11/22	8" @ 225'
1951	
1/17	8" @ 225
	Howard 1296 Stal 1998-2006
	5" @ 2000 TD 2056
	S/3 boph 60 qt2000
	S/12 boph
	Comp 50 bopd
	Completed TD 2056'
	COMPLETED

FORM 275 FOR SALE BY KANSAS BLUE PRINT CO.


County Sumner State Kansas

Sec. 23 (Blk. Twp.) 32 (Sur. Rge.) 2E Map No.

Operator Sunray & Lario

Well No. 20 Farm Wenrick

Elev. Location C E L SE NW NW

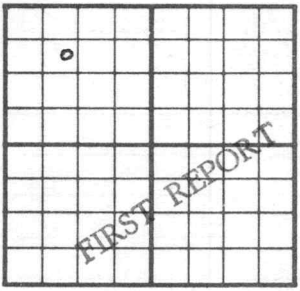

825 Ft. From N Line NW

990 Ft. From W Line Quarter

1st. Report NOV 22 1950

Completion

Remarks

Martin & Cash - Contr.

Spudding Date

Drlg. Data Oxford Pool

8" @ 225

J. E. TYRA

FORM 275 FOR SALE BY KANSAS BLUE PRINT CO.


County Sumner State Kansas

Sec. 23 (Blk. Twp.) 32 (Sur. Rge.) 2E Map No.

Operator Sunray & Lario

Well No. 20 Farm Wenrick

Elev. 1182 Location C E L SE NW NW

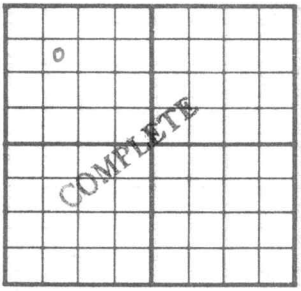

825 Ft. From N Line NW

990 Ft. From W Line Quarter

1st. Report

Completion JAN 17 1951

Remarks Oxford Pool

Martin & Cash - Contr.

Spudding Date

Drlg. Data Oil well TD 2056

8" @ 225 Howard 1296 Stal. 1998-2006

5" @ 2000 TD 2056 S/ 3 boph 60 qt/ 2000

S/ 12 boph Comp. 50 bopd

J. E. TYRA