


Map No. KANSAS Sec 23 Twp. 32 R. 2E
Well No. 1 A. Henrich Farm
Palmer & Barnsdall Company

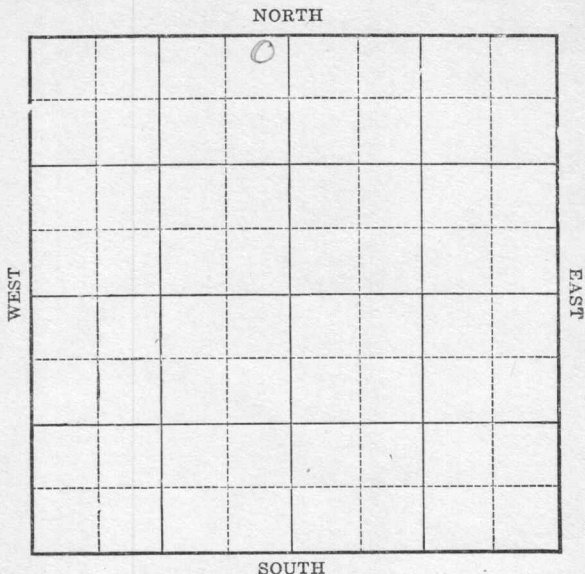

Location _____

Drilling Remarks _____

RECORD

Cased _____ in. _____ ft.

Sand _____

Gas _____

Oil _____

Total Depth _____

Rig Up _____

Drilling Remarks _____

PRODUCTION

1st 24 hrs. Nat. _____

1st 24 hrs. after shot _____


Gas _____ cu. ft.

Dry Hole _____

Abandoned _____

Map No. KANSAS Sec. 23 Twp. 32 R. 2EWell No. 1-H. Henrich Farm
Palmer-Barnsdall Company

NORTH

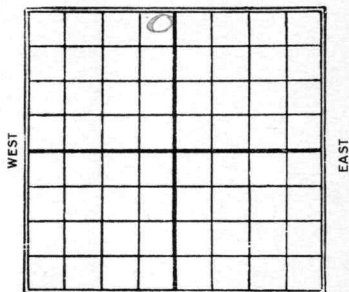170 Ft. from N. Line

Ft. from S. Line

250 Ft. from E. Line

Ft. from W. Line

SOUTH

1927 Twin #1

Date

REPORT

12/1 machine

~~12/18 Spud 2012 T.D. 2095~~
~~Shot 114 qts - 2038 - 94 -~~
~~400 bbls 24 bbls~~

12/18 Spud19281/4 Wrlg 325'1/11 " 4081/18 " 7301/25 " 11701/31 Sand 1285-1320 T.D.shot 30 qts 1215-1320 - No test -2/15 T.S. 1285 T.D. 130530/1215-132040 bbls oil20 " waterpumper

Map No. **KANSAS** Sec. 23 Twp. 32 R. 2E

Well No. 1 A. Veneick

Palmer & Barnsdall Company

Contractor

SECTION PLAT

	0		

170 Ft. from N. Line

_____ Ft. from S. Line

250 Ft. from E. Line

_____ Ft. from W. Line

FIRST REPORTS

Location _____

Rig up _____

Drilling and Remarks:

Machine

Twin No.

RECORD

Cased _____ in., _____ ft.

Sand _____

Gas _____

Oil _____

Total Depth _____

PRODUCTION

1st 24 hrs. Nat. _____

1st 24 hrs. after shot _____

Gas _____ Cu. Ft.

Dry Hole _____

Abandoned _____

Date

DEC 21 1927

192

S. J. LEWIS

Scout

Map No. **KANSAS** Sec. 23 Twp. 32 R. 27

Well No. 1 A. Dennis

Palmer & Barnsdall Company

Contractor

SECTION PLAT

	0		

170 Ft. from N. Line

_____ Ft. from S. Line

250 Ft. from E. Line

_____ Ft. from W. Line

COMPLETED

Location _____

Rig up _____

Drilling and Remarks:

78.1285

77.1305

30/1215-1320

40 x 12 oil

20 x 12 water

Palmer

RECORD

Cased _____ in., _____ ft.

Sand _____

Gas _____

Oil _____

Total Depth _____

PRODUCTION

1st 24 hrs. Nat. _____

1st 24 hrs. after shot _____

Gas _____ Cu. Ft.

Dry Hole _____

Abandoned _____

Date

FEB 15 1922

S. J. LEWIS Scout