


Form 51—5M—11-31—Palace

Map No. \_\_\_\_\_ Sec. 27 Twp. 18 R. 10 WWell No. 2- Kerzog Farm  
Slick Pryor - Lockhart Company

NORTH

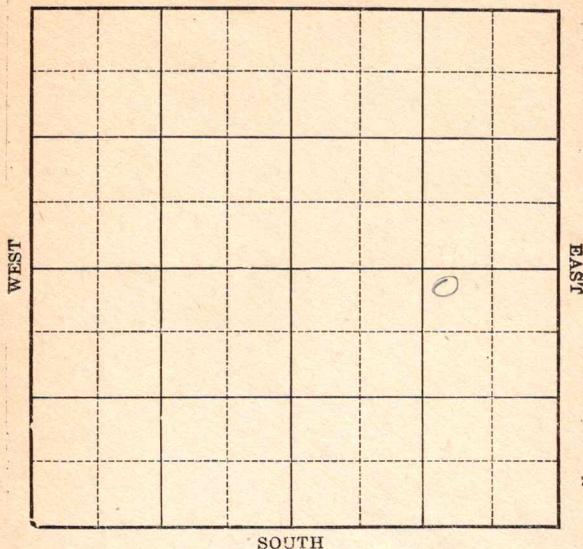

Location \_\_\_\_\_

Drilling Remarks \_\_\_\_\_

Rig Up \_\_\_\_\_

Drilling Remarks \_\_\_\_\_

## RECORD

Cased \_\_\_\_\_ in. \_\_\_\_\_ ft.

Sand \_\_\_\_\_

Gas \_\_\_\_\_

Oil \_\_\_\_\_

Total Depth \_\_\_\_\_

## PRODUCTION

1st 24 hrs. Nat. \_\_\_\_\_

1st 24 hrs. after shot \_\_\_\_\_

Gas \_\_\_\_\_ cu. ft.

Dry Hole \_\_\_\_\_


Abandoned \_\_\_\_\_

Map No. \_\_\_\_\_ Sec. 27 Twp. 18 R. 10-WWell No. 2- Herzog FarmSlick, Pryor, Lockhart Company330 Ft. from N. Line

\_\_\_\_\_ Ft. from S. Line

990 Ft. from E. Line

\_\_\_\_\_ Ft. from W. Line

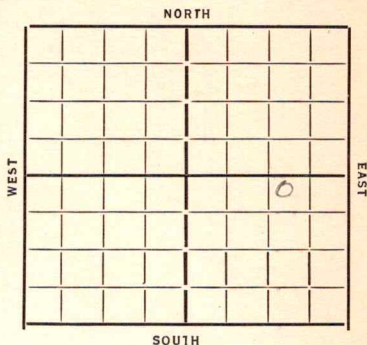

Date

1933

## REPORT

8/2 Location8/9 same8/17 —8/23 —8/30 —9/6 Rig9/13 —9/20 20"-67'9/29 15" at 192 - 13 3/8 432 - T.D. 91010/6 20000 gal 1410 Run 10" 1785'10/11 8" at 2475 - C.O.10/18 Pay 2680-85-1000' oil - swab  
147 bbls 36 hrs - 1000 gal  
acid, but no test yet10/25 Swab 286 bbls 24 hrs  
Running rods.11/1 pumped 132 bbls oil 11% B.S.  
Drilg 278511/8 T.D. 2980 - U.R. 6"11/15 Set 5" at 321311/22 Silurus 3213-3219  
554 bbls

COMPLETED

Map No. 55 Sec. 27 Twp. 18 R. 10WWell No. 2 - HerzogSlick payor & Lockhart Company

Contractor

## SECTION PLAT

330 Ft. from N. Line

Ft. from S. Line

990 Ft. from E. Line

Ft. from W. Line

|  |  |  |  |
|--|--|--|--|
|  |  |  |  |
|  |  |  |  |
|  |  |  |  |
|  |  |  |  |

FIRST REPORT

Location ✓

Rig up

Drilling and Remarks:

## RECORD

Cased 1 in., 1 ft.

Sand

Gas

Oil

Total Depth

## PRODUCTION

1st 24 hrs. Nat.

1st 24 hrs. after shot

Gas 1 Cu. Ft.

Dry Hole

Abandoned

Date

8/7/33 192 O. Mannschuck Scout

Map No. 55 Sec. 27 Twp. 18 R. 10W

Well No. 2-Herzog

Shick & Sons Company

Contractor

**COMPLETED**

# SECTION PLAT

330 Ft. from N. Line

Ft. from S. Line

990 Ft. from E. Line

Ft. from W. Line

|  |  |  |   |
|--|--|--|---|
|  |  |  |   |
|  |  |  |   |
|  |  |  | 0 |
|  |  |  |   |

Location

Rig up

Drilling and Remarks:

554 bbls

## RECORD

Cased \_\_\_\_\_ in., \_\_\_\_\_ ft.

Sand lit 3213

Gas \_\_\_\_\_

Oil \_\_\_\_\_

Total Depth 3219

## PRODUCTION

1st 24 hrs. Nat. \_\_\_\_\_

1st 24 hrs. after shot \_\_\_\_\_

Gas \_\_\_\_\_ Cu. Ft.

Dry Hole \_\_\_\_\_

Abandoned \_\_\_\_\_

Date

11-22-33 192 O. Mammuch Scout