


Form 51-5M-3-35-Mid-West

Map No. **KANSAS** Sec. 27 Twp. 18 R. 10W

Well No. 2-Mehl Farm  
Hinkle et al Company

NORTH

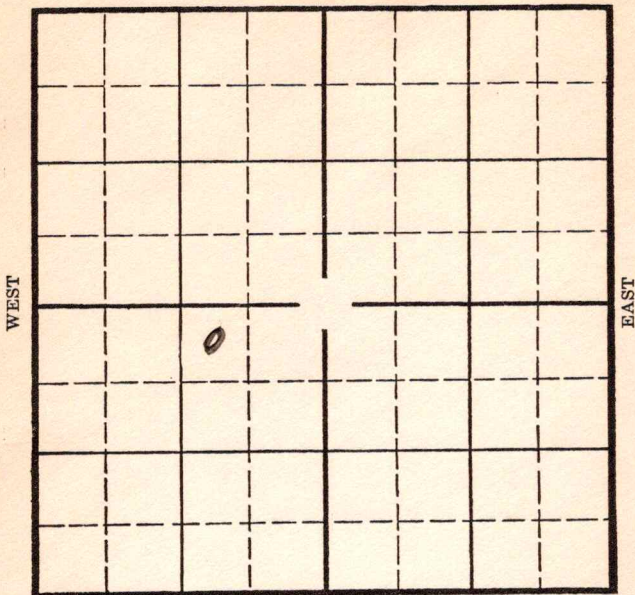

SOUTH

Location \_\_\_\_\_

Drilling Remarks \_\_\_\_\_  
\_\_\_\_\_  
\_\_\_\_\_  
Rig Up \_\_\_\_\_

Drilling Remarks \_\_\_\_\_  
\_\_\_\_\_  
\_\_\_\_\_  
RECORD

Cased \_\_\_\_\_ in. \_\_\_\_\_ ft.  
Sand \_\_\_\_\_  
Gas \_\_\_\_\_  
Oil \_\_\_\_\_  
Total Depth \_\_\_\_\_

PRODUCTION

1st 24 hrs. Nat. \_\_\_\_\_  
1st 24 hrs. after shot \_\_\_\_\_  
Gas \_\_\_\_\_ cu. ft. \_\_\_\_\_  
Dry Hole \_\_\_\_\_  
Abandoned \_\_\_\_\_

*Rice*  
*10W*

Map No.            Sec. 27 Twp. 18 R. 10W

Well No. 2-Mehl Farm           

Hinkle et al Company           


330 Ft. from N. Line

           Ft. from S. Line

990 Ft. from E. Line

           Ft. from W. Line

**Elev. 1751**

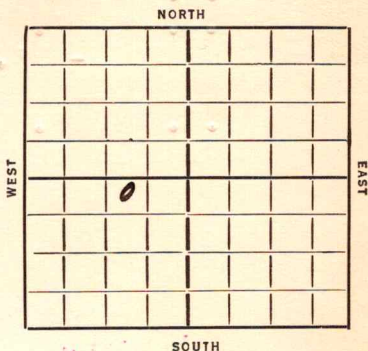

REPORT

~~0986~~  
~~3/4~~  
~~3/13~~

*Rog.*  
*B.T.*

- 3/20 Rign.
- 3/27 20" - 110 Drlg. 280'
- 4/2 15" - 447' Drlg. 1050'
- 4/10 12" @ 1241' Drlg. 1545'
- 4/16 Fishing 2260'
- 4/23 S.G. 1815' Drlg. 2005'.
- 4/30 8" @ 2475'. S.D. for repairs.
- 5/7 2630 U.R. 8".
- 5/14 S.O. & G. 2680-85'. 8" @ 2739'.  
Drlg. 2755'.
- 5/21 S.O. 2749-55'. Show gas 2885-2901'.  
2907' U.R. 8".
- 5/28 **K.C. 2957'**. 6" @ 2969'. Drlg.
- 6/4 6" @ 3004'. T.D. 3014'. U.R. 6".
- 6/11 Oil 3065'-69'. Est. 100 bbls oil.  
Quartzite 3172-75'. T.D.

**OVER**

7/8/36-P.B. to 3202½'.

K.C. 2857'.

Pay 3065-69'.

2000 gallons of acid.

T.D. 3204'.

271 bbls of oil.

**COMPLETED**

KANSAS

Map No. 55 Sec. 27 Twp. 18 R. 10W

Well No. 2-Mehl

Hinkle et al Company

Contractor

FIRST REPORTS

SECTION PLAT

330 Ft. from N. Line

..... Ft. from S. Line

990 Ft. from E. Line

..... Ft. from W. Line

	0		

Location.....

Rig up.....

Drilling and Remarks:

Log

RECORD

Cased..... in., ..... ft.

Sand.....

Gas.....

Oil.....

Total Depth.....

PRODUCTION

1st 24 hrs. Nat.....

1st 24 hrs. after shot.....

Gas..... Cu. Ft.

Dry Hole.....

Abandoned.....

Date

3-4-36

ORVAL MANNSCHRECK

Scout

**KANSAS**

Map No. 35 Sec. 27 Twp. 18 R. 10W

Well No. 2 Step 6

Hinkle & Co Company

Contractor

**SECTION PLAT**

330 Ft. from N. Line

\_\_\_\_\_ Ft. from S. Line

990 Ft. from E. Line

\_\_\_\_\_ Ft. from W. Line

	0		

COMPLETED

Location \_\_\_\_\_

Rig up \_\_\_\_\_

Drilling and Remarks:

P.B. & .3202 1/2

MC 2857

Pay 3065-69

2000 acid

271 yds

**RECORD**

Cased \_\_\_\_\_ in., \_\_\_\_\_ ft.

Sand \_\_\_\_\_

Gas \_\_\_\_\_

Oil \_\_\_\_\_

Total Depth 3204

**PRODUCTION**

1st 24 hrs. Nat. \_\_\_\_\_

1st 24 hrs. after shot \_\_\_\_\_

Gas \_\_\_\_\_ Cu. Ft.

Dry Hole \_\_\_\_\_

Abandoned \_\_\_\_\_

Date

JUL 8 1936 19

S. J. LEWIS Scout