

Rice


FORM 51 IOM 12-46 PETROL

KANSAS

Section 27 Township 18 Range 10-W

Well No. #3 Habiger "A"

Company Sunray
Habiger Pool

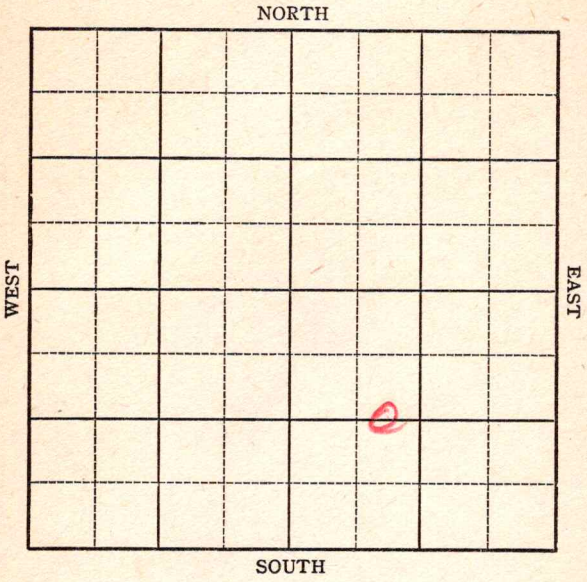

KANSAS

Rice county

Sec. 27 Twp. 18 R. 10W

Well No. 3 Habiger "A" Farm

Sunray Company

1320


Ft. from N. Line

Ft. from S. Line

Ft. from E. Line

990

Ft. from W. Line

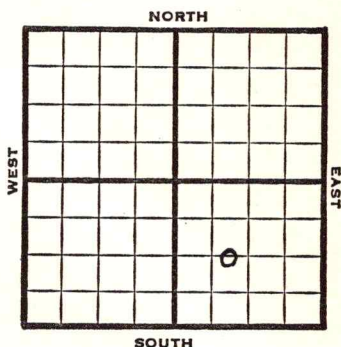

C E L W $\frac{1}{2}$ SE

1947

Elev. 1746'

REPORT

6/27

Location

7/1

8" @ 273'

Drlg 1810'

7/8

Lansing 2876'

RKC 3169'

Cong 3181'

Quartz 3216'

Drlg 3225'

7/16

Quart. 3216'

5" @ 3216'

T.D. 3225'

Abandoned

ABANDONED

Map No. _____ Sec. 27 Twp. 18 R. 10W

Well No. 3 Habiger "A"

Sunray

Company

FIRST REPORT

Contractor

C E L W $\frac{1}{2}$ SE


SECTION PLAT

1320 Ft. from N. Line

_____ Ft. from S. Line

_____ Ft. from E. Line

990 Ft. from W. Line

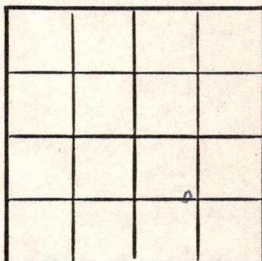

Rice County

Location X

Rig up _____

Drilling and Remarks:

RECORD

Cased _____ in., _____ ft.

Sand _____

Gas _____

Oil _____

Total Depth _____

PRODUCTION

1st 24 hrs. Nat. _____

1st 24 hrs. after shot _____

Gas _____ Cu. Ft.

Dry Hole _____

Abandoned _____

Date

JUN 25 1947 19

S. J. LEWIS

Scout

Map No. 55 Sec. 27 Twp. 18 R. 10W

Well No. 3 Habiger "A"

Sunray Company

ABANDONED Contractor

C E L W $\frac{1}{2}$ SE


E11746
SECTION PLAT

1320 Ft. from N. Line

 Ft. from S. Line

 Ft. from E. Line

990 Ft. from W. Line

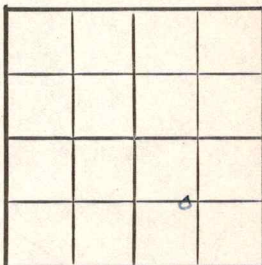

Rice County

Location

Rig up

Drilling and Remarks:

Quartzite 3216
5-11-3216

RECORD

Cased in., ft.

Sand

Gas

Oil

Total Depth 3225

PRODUCTION

1st 24 hrs. Nat.

1st 24 hrs. after shot

Gas Cu. Ft.

Dry Hole

Abandoned

Date

JUL 16 1947 19 S. J. LEWIS Scout