


Section 27 Township 18 Range 10W

Well No. #3 Mehl

Company Hinkle & Atlantic

Orth Pool

NORTH

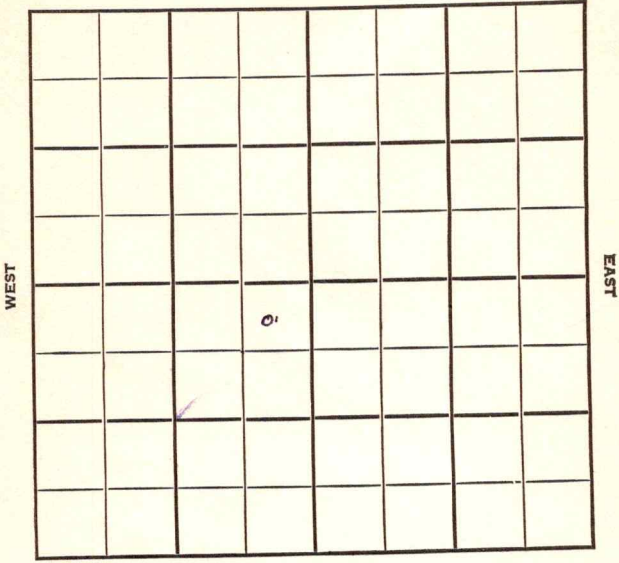

SOUTH

KANSAS

Rice County



Sec. 27 Twp. 18 R. LOW

Well No. #3 Mehl Farm _____
Hinkle & Atlantic Company

Orth Pool


330' Ft. from N. Line

_____ Ft. from S. Line

430' Ft. from E. Line

_____ Ft. from W. Line

NE SW Twin well

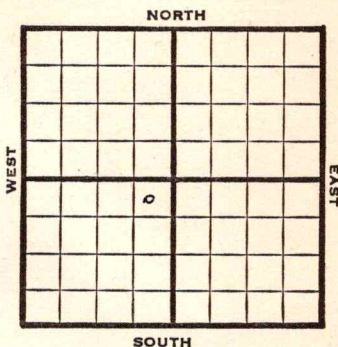

1948 **Elev. 1749'** REPORT

- 3/24 Location
- 3/31 "
- 4/7 8" @ 327'
Drlg. 1940'
- 4/14 **Topeka 2451'**
TD 2725'
5" @ 2725'
18 shots 2662-65'
24 " 2670-74 - 1½ bbls oil PH
- 4/21 500 Acid swb 30 bbls oil PH
6 hrs.
- 4/28 "
- 5/5 **Top 2451'**
5" @ 2725'
Perf Top
500 Acid
Pump 100 oil Pot.
Gr. 41°
TD 2725'
COMPLETED

Map No. _____ Sec. 27 Twp. 18 R. 10W

Well No. 3 Mehl

Hinkle & Atlantic Company

FIRST REPORT

Contractor

NE SW

SECTION PLAT

330 Ft. from N. Line

_____ Ft. from S. Line

430 Ft. from E. Line

_____ Ft. from W. Line

	o		

Rice County

Location X

Rig up _____

Drilling and Remarks:

twin well

RECORD

Cased _____ in., _____ ft.

Sand _____

Gas _____

Oil _____

Total Depth _____

PRODUCTION

1st 24 hrs. Nat. _____

1st 24 hrs. after shot _____

Gas _____ Cu. Ft.

Dry Hole _____

Abandoned _____

Date

MAR 24 1948 19

S. J. LEWIS Scout

Map No. 55 Sec. 27 Twp. 18 R. 10W

Well No. 3 Mehl

Hinkle & Atlantic Company

COMPLETE

Contractor

NE SW

E 11749
SECTION PLAT

330 Ft. from N. Line

_____ Ft. from S. Line

430 Ft. from E. Line

_____ Ft. from W. Line

	5		

Rice County

Location _____

Rig up _____

Drilling and Remarks:

Top 2451
5" @ 2725
Prof Top.
500 acid
Pump 100 oil Prod
41 2/3

RECORD

Cased _____ in., _____ ft.

Sand _____

Gas _____

Oil _____

Total Depth 2725

PRODUCTION

1st 24 hrs. Nat. _____

1st 24 hrs. after shot _____

Gas _____ Cu. Ft.

Dry Hole _____

Abandoned _____

Date

MAY 5 1948 19

S. J. LEWIS Scout