



Rice

Map No. KANSAS Sec. 27 Twp. 18 R. 10<sup>w</sup>


Well No. 3-Orth Farm \_\_\_\_\_  
Slick P & L Company \_\_\_\_\_

\_\_\_\_\_ Ft. from N. Line

330 Ft. from S. Line

\_\_\_\_\_ Ft. from E. Line

330 Ft. from W. Line

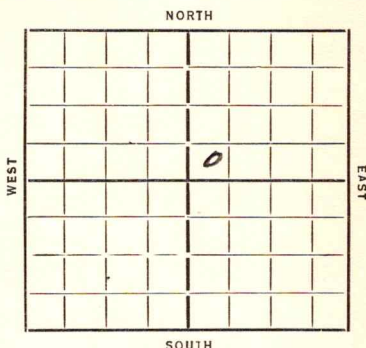

REPORT

O. W. D. D

Date	Well / Description	Depth / Notes
1935	Rig	
4/17	Rig	
4/26	Alg 200	15" 444
5/2	Alg 1187	13" 915
5/9		
5/16	sg 1360-70	1405-10
	10" 1602	sg 2025-30
	Alg 2380	
5/23	Alg 2650	
5/29	8" 2453	14FW 2595-2600
	S.O. 2665-70	300' oil 2675
	1500' 2705	S.W. 2770-75
	2895 U R 8"	
6/6	8" 2895	
6/13	K @ 2845 T 7	2945
	24 M Gas	R.P. 1030
6/19	K @ 2845 T 7	2945
	24 M Gas	

COMPLETED

O. W. D. D

1935		
6/26	Alg 2945	
7/3		

OVER

7/11 HFW 3142 WR6"

7/18 AD 3154-56

Oil 3165-67

200' 24 hrs 3178 T7

8/8 PB 2950

8/15 —

8/21 T7 3178 PB 2950

15 gm Gas

1045 # R.P.

COMPLETED

Map No. 55 Sec. 27 Twp. 18 R. 10W

Well No. 3-Orth

Slick P & L Company

Contractor

**COMPLETED**

SECTION PLAT

		0	

..... Ft. from N. Line

330 Ft. from S. Line

..... Ft. from E. Line

330 Ft. from W. Line

Location.....

Rig up.....

Drilling and Remarks:

P.B. 2950

15 m gas

1045# R.P.

RECORD

Cased..... in., ..... ft.

Sand.....

Gas.....

Oil.....

Total Depth. 3178

PRODUCTION

1st 24 hrs. Nat.....

1st 24 hrs. after shot.....

Gas..... Cu. Ft.

Dry Hole.....

Abandoned.....

Date

8-21-35 192.....

ORVAL MANNSCHRECK

Scout

Map No. 55 Sec. 27 Twp. 18 R. 10W

Well No. 3-Orth

Slick P + L Company

Contractor

FIRST REPORTS

SECTION PLAT

		0	

Ft. from N. Line

330

Ft. from S. Line

Ft. from E. Line

330

Ft. from W. Line

RECORD

Location.....

Cased.....in., .....ft.

Rig up.....

Sand.....

Drilling and Remarks:

Gas.....

Oil.....

Total Depth.....

PRODUCTION

1st 24 hrs. Nat.....

1st 24 hrs. after shot.....

Gas.....Cu. Ft.

Dry Hole.....

Abandoned.....

Date

ORVAL MANNSCHRECK

4-17-35 192

Scout

Rig

KANSAS

Map No. 55 Sec. 27 Twp. 18 R. 10W

Well No. 3-Orth

Slick. p & L Company

Contractor

COMPLETED

SECTION PLAT

.....Ft. from N. Line

330 Ft. from S. Line

.....Ft. from E. Line

330 Ft. from W. Line

		0	

Location.....

Rig up.....

Drilling and Remarks:

24 m gas

RECORD

Cased.....in.,.....ft.

Sand KC 2845

Gas.....

Oil.....

Total Depth 2945

PRODUCTION

1st 24 hrs. Nat.....

1st 24 hrs. after shot.....

Gas.....Cu. Ft.

Dry Hole.....

Abandoned.....

Date

6-19-35

192.....

ORVAL MANNSCHECK

Scout

Map No. 55 Sec. 27 Twp. 18 R. 10 W

Well No. 3 Orth.

Slick-Pryor & Lockhart Company  
Contractor

SECTION PLAT

		0	

.....Ft. from N. Line

320 Ft. from S. Line

.....Ft. from E. Line

330 Ft. from W. Line

FIRST REPORTS

0 W 117

Location.....

Rig up.....

Drilling and Remarks:

2945

RECORD

Cased.....in., .....ft.

Sand.....

Gas.....

Oil.....

Total Depth.....

PRODUCTION

1st 24 hrs. Nat.....

1st 24 hrs. after shot.....

Gas.....Cu. Ft.

Dry Hole.....

Abandoned.....

Date

6/26/35 192.....

ORVAL MANNSCHECK

Scout