


Section 27 Township 18 Range 10 W

Well No. #2 Herzog

Company B & B Drlg.

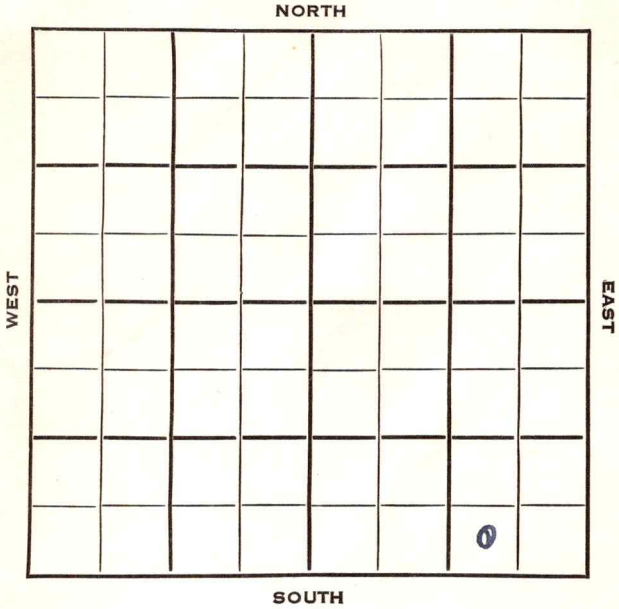


Rice **KANSAS**

SEC.	TWP.	R.	✓
27	18	10 W	
WELL NO.			
# 2 Herzog			FARM
COMPANY			
B & B Drlg.			
CONTRACTOR			

Orth Pool

\_\_\_\_\_ Ft. from N. Line  
 330 \_\_\_\_\_ Ft. from S. Line  
 990 \_\_\_\_\_ Ft. from E. Line  
 \_\_\_\_\_ Ft. from W. Line

SW SE SE

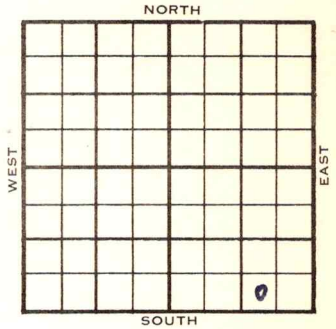

1953	ELEVATION	REPORT
	1741'	
10/28		Spud 10-23-53 8" @ 184' Anhy 420 Drlg. 2475'
11/4		Top 2457' DST 2667-78, 1 hr., 320' gas, 40' ocm, 150# Heeb 2718', Br li 2834', Lans 2852', Oct 3153' DST 3130-54, 75 mins., 620' gas, 210' hocm, 150# RTD 3156' 5" @ 3156'
11/11		DD 3175' TD, NS PB 48/3147-55, S/ 1/2 BO 1 hrs. Sd-frac
11/18		NR
12/16		NR
12/30		Spud 10-23-53 Oil Well TD 3175' 8" @ 184' Anhy 420', Top 2457', DST 2667'-78' opn 1 hr, rec 320' gas 40' ocm 150# Heeb 2718', Br. Lime 2834'

**OVER**

1953

Information brought forward.

12/30

**Lans 2852' Qt 3153'**

DST 3130'-54' opn 75 min, rec 620' gas  
210' hocm 150#

TD 3152'

5" @ 3152'

DD 3175'

48/ 3147'-55' S/  $\frac{1}{2}$  bo 1 hr. sd-frac

P/ 11 bopd PB 3100 45/ 3039-55

2000 A

Comp 30 bopd.

**COMPLETED**



