


*Rice*

Map No. \_\_\_\_\_ Sec. *27* Twp. *18* R. *10* <sup>W</sup>

Well No. *2 Orth* Farm \_\_\_\_\_  
*Slick, Pryor & Lockhart* Company

NORTH

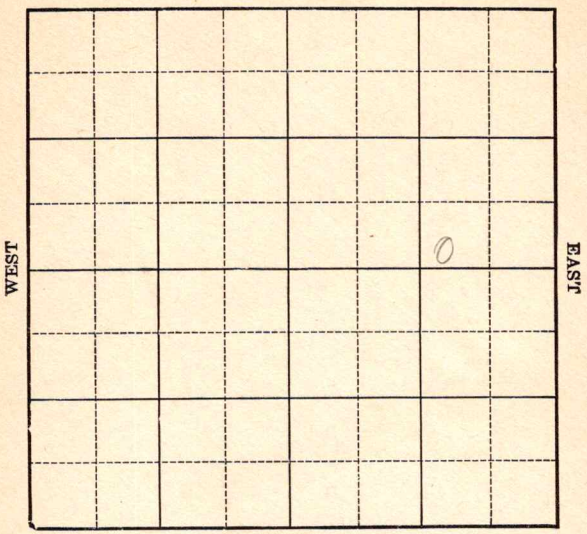

SOUTH

Location \_\_\_\_\_  
Drilling Remarks \_\_\_\_\_

Rig Up \_\_\_\_\_  
Drilling Remarks \_\_\_\_\_

\_\_\_\_\_

\_\_\_\_\_

**RECORD**

**PRODUCTION**

Cased \_\_\_\_\_ in. \_\_\_\_\_ ft.

Sand \_\_\_\_\_

Gas \_\_\_\_\_

Oil \_\_\_\_\_

Total Depth \_\_\_\_\_

1st 24 hrs. Nat. \_\_\_\_\_

1st 24 hrs. after shot \_\_\_\_\_

Gas \_\_\_\_\_ cu. ft.

Dry Hole \_\_\_\_\_

Abandoned \_\_\_\_\_

Rice

Map No. KANSAS Sec. 27 Twp. 18 R. 10<sup>00</sup>

Well No. 2 Orth Farm


Slick Pryor & Lockhart Company

\_\_\_\_\_ Ft. from N. Line

330 Ft. from S. Line

990 Ft. from E. Line

\_\_\_\_\_ Ft. from W. Line

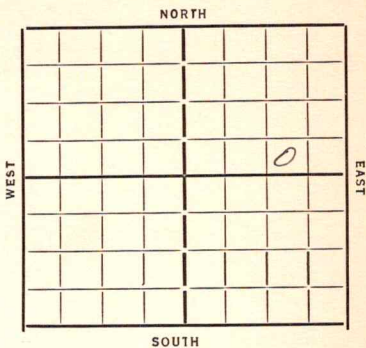

Date 1933

REPORT

12/6 Location

12/13 Roads + material on ground

12/27 20" at 176 - 15" at 440  
dreg 510

1/11 Show gas 2045  
dreg 2450

1/17 8" at 2482  
show gas 2900  
6" 2933 - C.O

1/24 Show gas 2940 - 45  
6" at 3002  
cong. 3188 - 3253  
fishing 3262

1/31 Cong 3188 - 3253 TD 3272 Dra

ABANDONED

Map No. 55 Sec. 27 Twp. 18 R. 10W

Well No. 2-Orth


Contractor

**ABANDONED**

**SECTION PLAT**

			0

.....Ft. from N. Line

330 Ft. from S. Line

990 Ft. from E. Line

.....Ft. from W. Line

Location.....

Rig up.....

Drilling and Remarks:

NO + H

**RECORD**

Cased.....in.,.....ft.

Sand 3188-3253

Gas.....

Oil.....

Total Depth 3272

**PRODUCTION**

1st 24 hrs. Nat.....

1st 24 hrs. after shot.....

Gas.....Cu. Ft.

Dry Hole.....

Abandoned.....

Date

1-31-34 192 O. J. Mammel Scout

Map No. 55 Sec. 27 Twp. 18 R. 10W

Well No. 3. Orth

Slick, pyro & Hookhart Company

Contractor

SECTION PLAT

			0

Ft. from N. Line

330 Ft. from S. Line

990 Ft. from E. Line

Ft. from W. Line

**NEAST REPORTS**

Location

Rig up

Drilling and Remarks:

RECORD

Cased.....in., .....ft.

Sand.....

Gas.....

Oil.....

Total Depth.....

PRODUCTION

1st 24 hrs. Nat.....

1st 24 hrs. after shot.....

Gas.....Cu. Ft.

Dry Hole.....

Abandoned.....

Date

12-6-33 192

O. Mammuluck Scout