

KANSAS


Rice County

FORM 51 5M 1-42 PETROL

Section 27 Township 18 Range 10W

Well No. 5 Orth

Company Transwestern etal.

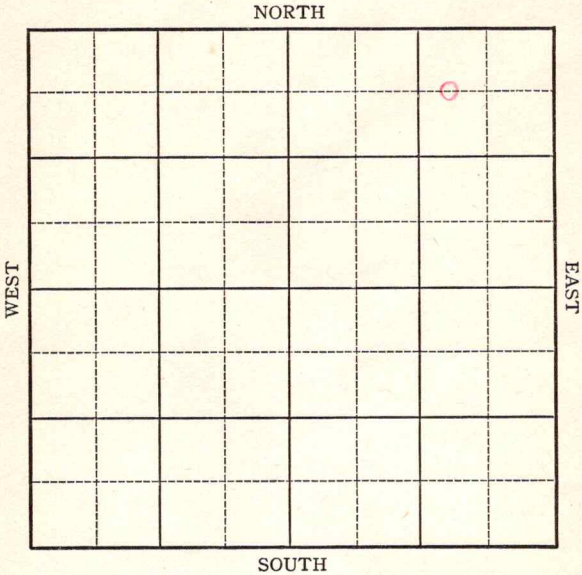

KANSAS

Rice

Sec. 27 Twp. 18 R. 10W

Well No. #5 Orth _____ Farm _____

_____ Transwestern et al _____ Company


Orth

660' Ft. from N. Line

_____ Ft. from S. Line

990' Ft. from E. Line

_____ Ft. from W. Line

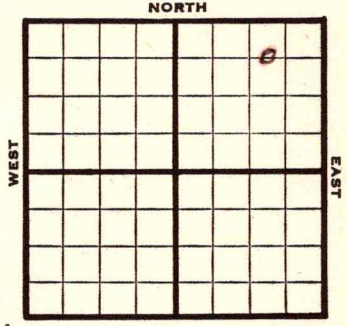

Elev. 1747

REPORT

1944

6/28 8" @ 182 WOC

7/12 Cong 3240
Arb 3288
TD 3303

ABANDONED

Pool Name Orth

KANSAS

Map No. 58 Sec. 27 Twp. 18 R. 10W

Well No. 5 Orth

Transwestern etal. Company

FIRST REPORT Contractor

C W L NE NE

SECTION PLAT

660 Ft. from N. Line

_____ Ft. from S. Line

990 Ft. from E. Line

_____ Ft. from W. Line

			o

Rice County

Location _____

Rig up _____

Drilling and Remarks:

8" - 182 , WOC

RECORD

Cased _____ in., _____ ft.

Sand _____

Gas _____

Oil _____

Total Depth _____

PRODUCTION

1st 24 hrs. Nat. _____

1st 24 hrs. after shot _____

Gas _____ Cu. Ft.

Dry Hole _____

Abandoned _____

Date

JUN 28 1944 19

S. J. LEWIS Scout

Pool Name Orth

Map No. 55 **KANSAS** Sec. 27 Twp. 18 R. 10W

Well No. 5 Orth

Transwestern etal. Company

ABANDONED Contractor

C W L N E N E

SECTION PLAT

660 Ft. from N. Line

_____ Ft. from S. Line

990 Ft. from E. Line

_____ Ft. from W. Line

			0

Rice County

Location _____

Rig up _____

Drilling and Remarks:

Cong 3240
Ar 8288

RECORD

Cased _____ in., _____ ft.

Sand _____

Gas _____

Oil _____

Total Depth 3388

PRODUCTION

1st 24 hrs. Nat. _____

1st 24 hrs. after shot _____

Gas _____ Cu. Ft.

Dry Hole _____

Abandoned _____

Date

JUL 12 1940 19

S. J. LEWIS Scout