

Rice

KANSAS

Section 27 Township 18 Range 10WWell No. 5 Volkland "A"Company Skelly

|  |  |   |  |  |  |  |  |
|--|--|---|--|--|--|--|--|
|  |  |   |  |  |  |  |  |
|  |  |   |  |  |  |  |  |
|  |  | 0 |  |  |  |  |  |
|  |  |   |  |  |  |  |  |
|  |  |   |  |  |  |  |  |
|  |  |   |  |  |  |  |  |
|  |  |   |  |  |  |  |  |
|  |  |   |  |  |  |  |  |

Habiger NORTH

WEST EAST

SOUTH

KANSAS

Rice

Sec. 27 Twp. 18 R. 10-W

Well No. #5 Volkland "A" Farm

Skelly Company

Habiger Pool


Ft. from N. Line

990' Ft. from S. Line

990' Ft. from E. Line

Ft. from W. Line

NW SE NW

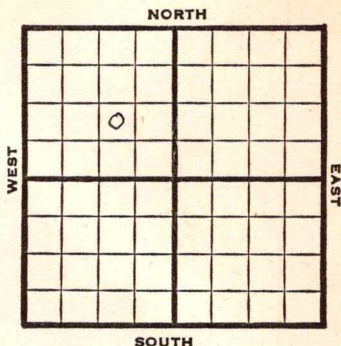

1947

Elev. 1752' REPORT

11/12 Location

11/19 RUR

11/25 8" @ 212'  
WOC

12/3 Lansing 2850'  
Quartzite 3127'  
TD 3131'  
Run 5"

12/10 5" @ 3127'  
RUST

12/17 96 shots 2657-74 1000 acid  
Swb 75 bbls oil & 1 W in 1 hr.

12/30 "

1948  
1/7 "

1/14 Lans. 2850'  
Quartzite 3127'  
Perf. Lans. 1000 acid  
Pump 127 oil / 7 W pot  
41.9 Gr.  
TD 3131'  
Comp.

COMPLETED

Map No. \_\_\_\_\_ Sec. 27 Twp. 18 R. 10W

Well No. 5 Volkland "A"

Skelly Company

FIRST REPORT

Contractor

NW SE NW

SECTION PLAT

|  |   |  |  |
|--|---|--|--|
|  |   |  |  |
|  | 0 |  |  |
|  |   |  |  |
|  |   |  |  |

\_\_\_\_\_ Ft. from N. Line

990 Ft. from S. Line

990 Ft. from E. Line

\_\_\_\_\_ Ft. from W. Line

Rice County

Location X

Rig up \_\_\_\_\_

Drilling and Remarks:

RECORD

Cased \_\_\_\_\_ in., \_\_\_\_\_ ft.

Sand \_\_\_\_\_

Gas \_\_\_\_\_

Oil \_\_\_\_\_

Total Depth \_\_\_\_\_

PRODUCTION

1st 24 hrs. Nat. \_\_\_\_\_

1st 24 hrs. after shot \_\_\_\_\_

Gas \_\_\_\_\_ Cu. Ft.

Dry Hole \_\_\_\_\_

Abandoned \_\_\_\_\_

Date

NOV 12 1947

19

S. J. LEWIS

Scout

Map No. 55 Sec. 27 Twp. 18 R. 10W

Well No. 5 Volkland "A"

Skelly Company

COMPLETE

Contractor

NW SE NW

*E 11/252*


SECTION PLAT

           Ft. from N. Line

990 Ft. from S. Line

990 Ft. from E. Line

           Ft. from W. Line

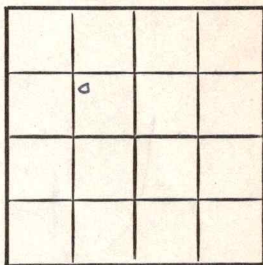

Rice County

Location                                 

Rig up                                 

Drilling and Remarks:

*Liams 2850*  
*Quartzite 8127*  
*Prof Liams.*  
*1000 acid*  
*Pump 127 oil + 7W*  
*Bot*  
*4128*

RECORD

Cased            in.,            ft.

Sand                                 

Gas                                 

Oil                                 

Total Depth 2131

PRODUCTION

1st 24 hrs. Nat.                                 

1st 24 hrs. after shot                                 

Gas                                  Cu. Ft.

Dry Hole                                 

Abandoned                                 

Date

JAN 14 1948 19

S. J. LEWIS

Scout