

KANSAS


Summer County

FORM 51 5M PETROL

Section 26 Township 32 Range 2E

Well No. 1 D. C. Dunn

Company Kansas Elevator

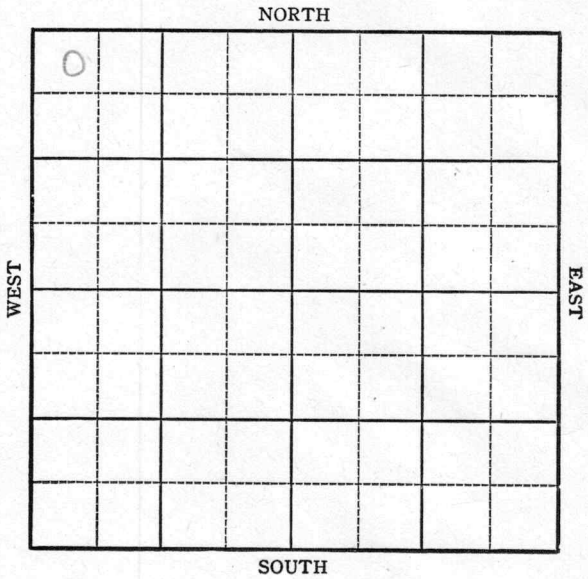

KANSAS

Summer County

Sec. 26 Twp. 32 R. 2E

Well No. 1 D. C. Dunn Farm
Kansas Elevator Company

Miscellaneous


330 Ft. from N. Line

_____ Ft. from S. Line

_____ Ft. from E. Line

330 Ft. from W. Line

NW/c Elev. 1181

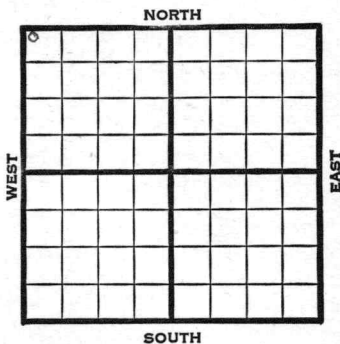

1945

REPORT

5/9 machine
5/17 "
5/24 Spud S.D.
5/31 20" @ 110
15" @ 465
Drlg. 695'
6/8 1230 fsg.
6/14 " "
6/21 Drlg. 1230
6/28 12" @ 1230
12" Collapsed
TD 1430
fsg
7/3 12" @ 1230
12" collapsed
TD 1430' fsg.
7/11 " " " "
7/19 " " " "
7/26 " " " "
8/1 10" @ 1500
Drlg. 1570
8/8 10" @ 1430
Drlg. 1880'
8/15 Drlg. 2500'
8/22 8" @ 1972
Stal 2220
2264 UR 8"
9/29 8" @ 2220
Drlg. 2300
9/5 Drlg. 2333

OVER

1945

9/12	Lay	2600
	KC	2640
	Drlg.	2780'
9/19	Drlg.	2860
9/26	Miss.	3070
	7" @	2775
	Drlg.	3130'
10/3	"	"
10/10	Miss.	3070
	TD	3125'

ABANDONED


Kansas Pool Name MiscellaneousMap No. 1 Sec. 26 Twp. 32 R. 2EWell No. 1 D.C. DunnKansas Elevator Company

FIRST REPORT

Contractor

NW/c

SECTION PLAT

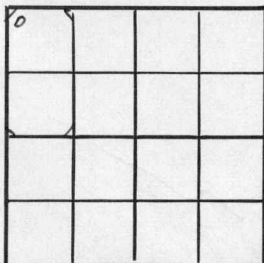330 Ft. from N. Line Ft. from S. Line Ft. from E. Line330 Ft. from W. Line

Sumner County

Location

Rig up

Drilling and Remarks:
machine

RECORD

Cased in., ft.Sand Gas Oil Total Depth

PRODUCTION

1st 24 hrs. Nat. 1st 24 hrs. after shot Gas Cu. Ft.Dry Hole Abandoned

Date

MAY 9 1945 19

S. J. LEWIS

Scout

KANSAS Kansas Pool Name MiscellaneousMap No. 7 Sec. 26 Twp. 32 R. 2EWell No. 1 D. C. Dunn

Kansas Elevator _____ Company

ABANDONED

Contractor _____

NW/c

21,1187
SECTION PLAT.

0			

330 Ft. from N. Line

_____ Ft. from S. Line

_____ Ft. from E. Line

330 Ft. from W. Line

Sumner County

Location _____

Rig up _____

Drilling and Remarks:

Miss 3070

RECORD

Cased _____ in., _____ ft.

Sand _____

Gas _____

Oil _____

Total Depth 3125

PRODUCTION

1st 24 hrs. Nat. _____

1st 24 hrs. after shot _____

Gas _____ Cu. Ft.

Dry Hole _____

Abandoned _____

Date

OCT 10 1945 19S. J. LEWIS

Scout