


Section 27 Township 18 Range 10 W

Well No. # 4 Habiger

Company Musgrove Pet.

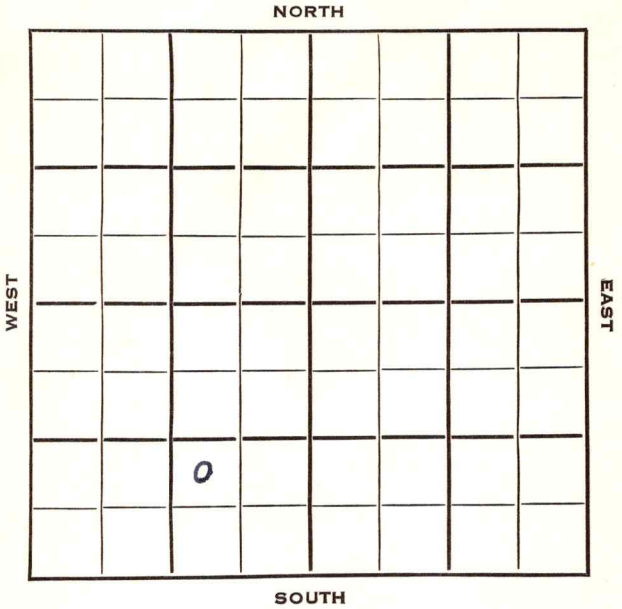

Sec. 27 Twp. 18 R. 10 W

Well No. # 4 Habiger Farm

Musgrove Pet. Company

Salina Drlg. Contractor

Orth Pool


\_\_\_\_\_ Ft. from N. Line

990 Ft. from S. Line

\_\_\_\_\_ Ft. from E. Line

1600 Ft. from W. Line

NW SE SW (Twin)

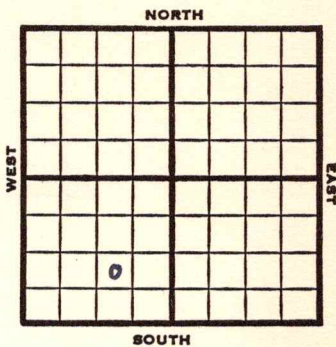

1953

**Elev. 1750'** REPORT

8/26

Spud 8-21-53  
Drlg. 1661'

9/2

RTD 3147½  
5" @ 3147'

9/9

DD 3150  
8 goph

9/16

NR

10/7

Spud 8-21-53 Oil well TD 3155  
**Top 2460 Heeb 2722 Tor 2738**  
**Br lime 2842 Lans 2860 Cong 3127**  
TD 3147 5" @ 3147 DD 3150 8 GOPH  
DD 3155 27 GOPH 9 hr. Oil-frac.  
S/111 BF 1 hr. 9% wtr.  
Comp. 25 BOPD 75% wtr.

**COMPLETED**



