

Section 27 Township 18 Range 10W

Well No. #5 Habiger

Company Artnell

Habiger Pool

NORTH

			0				

WEST

EAST

SOUTH

KANSAS

Rice

Sec. 27 Twp. 18 R. 10W

Well No. #5 Habiger Farm  
Artnell Company

Habiger


330 Ft. from N. Line

Ft. from S. Line

330 Ft. from E. Line

Ft. from W. Line

NE NW

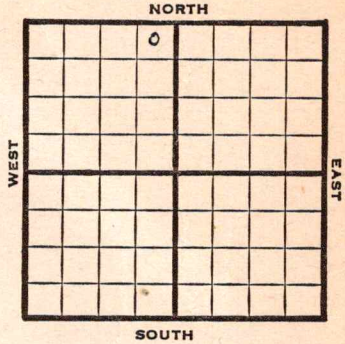

1947

Elev. 1751' REPORT

10/29

Location

11/5

10" @ 240'  
Drlg. 1760'

11/12

Topeka 2435'  
Heebner 2699'  
TD 2700'  
Run 7" csg.

11/19

Skid Rig 90' West

11/25

10" @ 235'  
Drlg. 1945'

12/3

Topeka 2435'  
Heebner 2699'  
TD 2700'  
7" @ 2700'  
RUST

12/10

10"

12/30

Topeka 2435'  
Heeb 2699'  
7" @ 2700'  
Pipe trouble  
TD 2700'

ABANDONED

Map No. \_\_\_\_\_ Sec. 27- Twp. 18 R. 10W

Well No. 5 Habiger

Artnell Company

FIRST REPORT Contractor

NE NW

SECTION PLAT

330 Ft. from N. Line

\_\_\_\_\_ Ft. from S. Line

330 Ft. from E. Line

\_\_\_\_\_ Ft. from W. Line

		o	

Rice County

Location X

Rig up \_\_\_\_\_

Drilling and Remarks:

RECORD

Cased \_\_\_\_\_ in., \_\_\_\_\_ ft.

Sand \_\_\_\_\_

Gas \_\_\_\_\_

Oil \_\_\_\_\_

Total Depth \_\_\_\_\_

PRODUCTION

1st 24 hrs. Nat. \_\_\_\_\_

1st 24 hrs. after shot \_\_\_\_\_

Gas \_\_\_\_\_ Cu. Ft.

Dry Hole \_\_\_\_\_

Abandoned \_\_\_\_\_

Date

OCT 29 1947 19

S. J. LEWIS Scout

Map No. 55 Sec. 27 Twp. 18 R. 10W

Well No. 5 Habiger

Artnell Company

ABANDONED Contractor

NE NW

*E 1, 1751*  
SECTION PLAT

	0		

330 Ft. from N. Line

\_\_\_\_\_ Ft. from S. Line

330 Ft. from E. Line

\_\_\_\_\_ Ft. from W. Line

Rice County

RECORD

Location \_\_\_\_\_

Cased \_\_\_\_\_ in., \_\_\_\_\_ ft.

Rig up \_\_\_\_\_

Sand \_\_\_\_\_

Drilling and Remarks:

Gas \_\_\_\_\_

Oil \_\_\_\_\_

Total Depth 2700

*Topok 2485*

*Heet 2689*

*7" @ 2700*

*Pipe to 2700*

PRODUCTION

1st 24 hrs. Nat. \_\_\_\_\_

1st 24 hrs. after shot \_\_\_\_\_

Gas \_\_\_\_\_ Cu. Ft.

Dry Hole \_\_\_\_\_

Abandoned \_\_\_\_\_

Date

DEC 30 1947 19

S. J. LEWIS Scout