


Section 27 Township 18 Range 10W

Well No. #6 Orth

Company Sunray

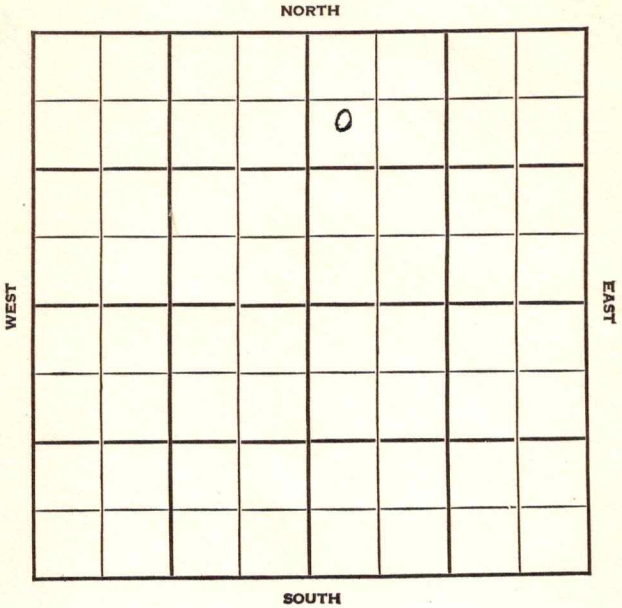

Sec. 27 Twp. 18 R. 10W

Well No. #6 Orth Farm \_\_\_\_\_

Sunray Company \_\_\_\_\_

Silica


915 Ft. from N. Line

\_\_\_\_\_ Ft. from S. Line

\_\_\_\_\_ Ft. from E. Line

330 Ft. from W. Line

SW NW NE

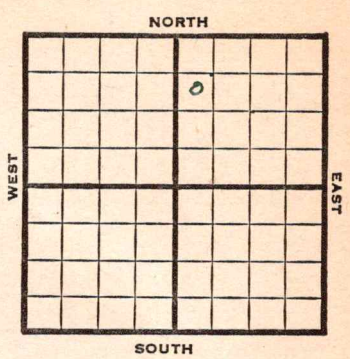

1947 **Elev. 1753'** REPORT

12/3 Twin well  
RUR

12/10 10" @ 234'  
Drlg. 1825'

12/23 **Topeka 2457'**  
7" @ 2672'  
500 acid  
Pump 250 Pot  
Gr. 38.0  
TD 2677'

**COMPLETED**

Map No. \_\_\_\_\_ Sec. 27 Twp. 18 R. 10W

Well No. 6 Orth

Sunray Company

FIRST REPORT Contractor

SW NW NE

SECTION PLAT

915 Ft. from N. Line

\_\_\_\_\_ Ft. from S. Line

\_\_\_\_\_ Ft. from E. Line

330 Ft. from W. Line

		D	

Rice County

Location \_\_\_\_\_

Rig up \_\_\_\_\_

Drilling and Remarks:

twin well

R U R

RECORD

Cased \_\_\_\_\_ in., \_\_\_\_\_ ft.

Sand \_\_\_\_\_

Gas \_\_\_\_\_

Oil \_\_\_\_\_

Total Depth \_\_\_\_\_

PRODUCTION

1st 24 hrs. Nat. \_\_\_\_\_

1st 24 hrs. after shot \_\_\_\_\_

Gas \_\_\_\_\_ Cu. Ft.

Dry Hole \_\_\_\_\_

Abandoned \_\_\_\_\_

Date

DEC 3 1947 19 \_\_\_\_\_

S. J. LEWIS Scout

Map No. 55 Sec. 27 Twp. 18 R. 10W

Well No. 6 Orth

Sunray Company

COMPLETE

Contractor

SW NW NE

E 11253  
SECTION PLAT

915 Ft. from N. Line

\_\_\_\_\_ Ft. from S. Line

\_\_\_\_\_ Ft. from E. Line

330 Ft. from W. Line

		0	

Rice County

Location \_\_\_\_\_

Rig up \_\_\_\_\_

Drilling and Remarks:

*Topoka 2457*  
*7" @ 2672*  
*500 cu. ft.*  
*Pump 250 ft*  
*380 ft*

RECORD

Cased \_\_\_\_\_ in., \_\_\_\_\_ ft.

Sand \_\_\_\_\_

Gas \_\_\_\_\_

Oil \_\_\_\_\_

Total Depth 2677

PRODUCTION

1st 24 hrs. Nat. \_\_\_\_\_

1st 24 hrs. after shot \_\_\_\_\_

Gas \_\_\_\_\_ Cu. Ft.

Dry Hole \_\_\_\_\_

Abandoned \_\_\_\_\_

Date

DEC 23 1947 19

S. J. LEWIS

Scout