


Section 27 Township 18 Range 10W

Well No. #6 Volkland "A"

Company Skelly
Habiger

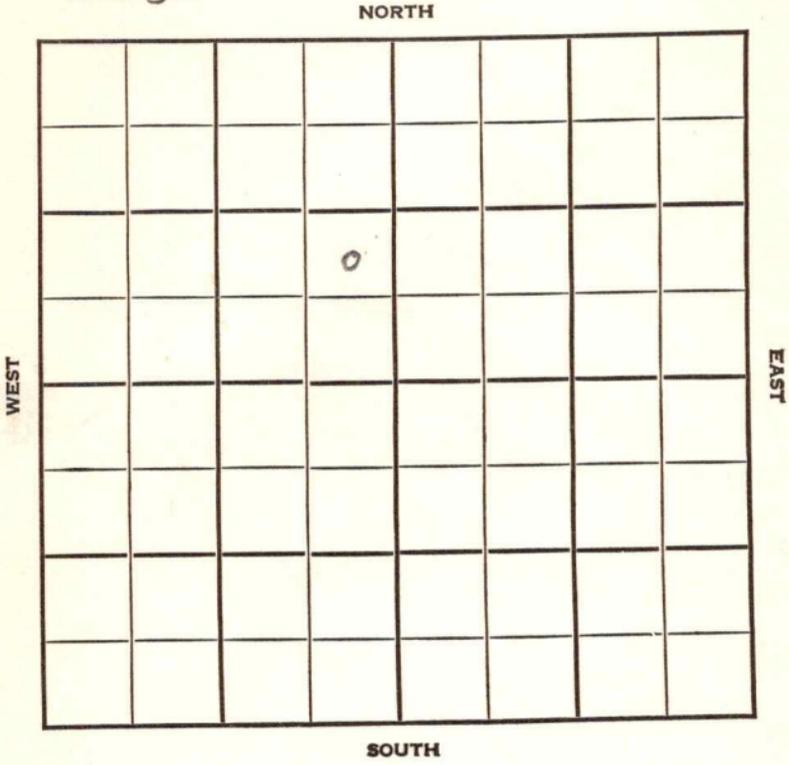



Sec. 27 Twp. 18 R. 10W

Well No. #6 Volkland "A" Farm

Skelly Company

Habiger Pool


Ft. from N. Line

990' Ft. from S. Line

330' Ft. from E. Line

Ft. from W. Line

NE SE NW

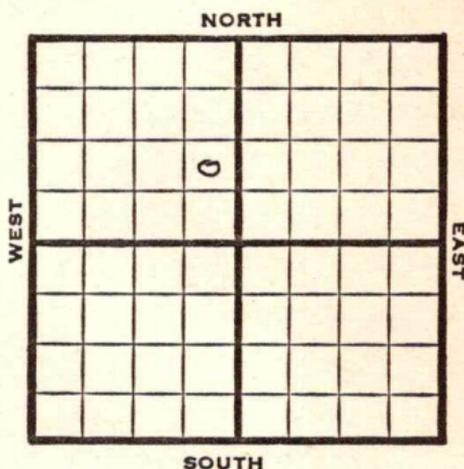

1948

Elev. 1756'

REPORT

1/7 8" @ 226'

WOC

1/14 Topeka 2452'

5" @ 2680 TD

1/21 "

1/26 "

2/4 Topeka 2452'

5" @ 2680'

Perf.

1000 acid

Pump 100 Pot

Gr. 41.0

TD 2680'

Comp.

COMPLETED

Map No. _____ Sec. 27 Twp. 18 R. 10W

Well No. 6 Volkland "A"

Skelly Company

FIRST REPORT Contractor

NE SE NW

SECTION PLAT

_____ Ft. from N. Line

990 Ft. from S. Line

330 Ft. from E. Line

_____ Ft. from W. Line

	o		

Rice County

Location _____

Rig up _____

Drilling and Remarks:

8" @ 226 WOC

RECORD

Cased _____ in., _____ ft.

Sand _____

Gas _____

Oil _____

Total Depth _____

PRODUCTION

1st 24 hrs. Nat. _____

1st 24 hrs. after shot _____

Gas _____ Cu. Ft.

Dry Hole _____

Abandoned _____

Date

JAN 7 1948 19

S. J. LEWIS Scout

