


KANSAS

Section 27 Township 18 Range 10WWell No. #7 M OrthCompany Sunray
Chase Pool

NORTH

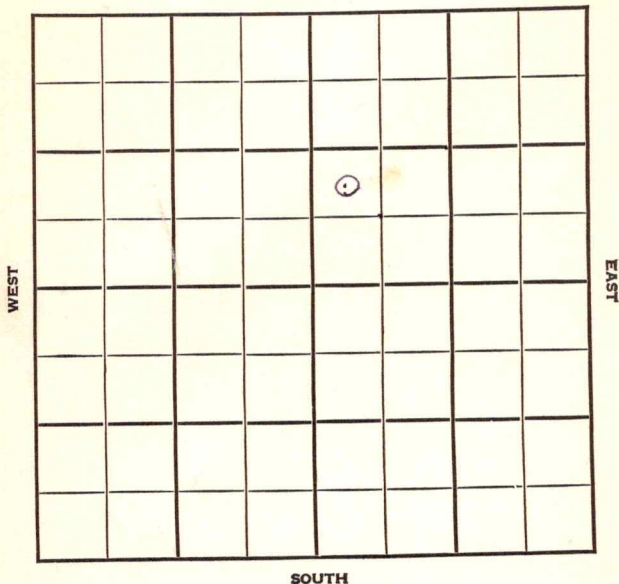

KANSAS

Rice County



Sec. 27 Twp. 18 R. 10W

Well No. #7 M. Orth Farm

Sunray Company


Chase Pool

 Ft. from N. Line

990 Ft. from S. Line

 Ft. from E. Line

330 Ft. from W. Line

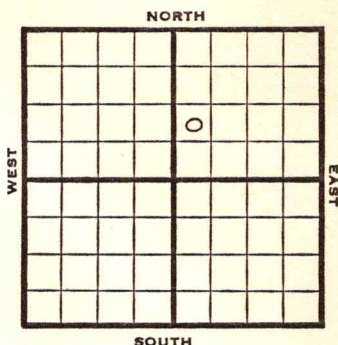

NW SW NE

1948

Elev. 1750' REPORT

4/21

13" @ 235'
Drlg. 1630'

4/28

Topeka 2458'
TD 2674'
7" @ 2672'
RUST

5/5

TD 2680'
Swb. 125 bbls. oil / 65 Water

5/12

"

5/19

"

6/1

Top 2458'
7" @ 2672'
Pump 65 oil Pot.
Gr. 41°
TD 2680'

COMPLETED

Map No. _____ Sec. 27 Twp. 18 R. 10W

Well No. 7 M. Orth

Sunray Company

FIRST REPORT Contractor

NW SW NE

SECTION PLAT

		0	

_____ Ft. from N. Line

990 Ft. from S. Line

_____ Ft. from E. Line

330 Ft. from W. Line

Rice County

Location _____

Rig up _____

Drilling and Remarks:

13" @ 235

drlg. 1630

RECORD

Cased _____ in., _____ ft.

Sand _____

Gas _____

Oil _____

Total Depth _____

PRODUCTION

1st 24 hrs. Nat. _____

1st 24 hrs. after shot _____

Gas _____ Cu. Ft.

Dry Hole _____

Abandoned _____

Date

APR 21 1948

19

S. J. LEWIS

Scout

Map No. 55 Sec. 27 Twp. 18 R. 10W

Well No. 7 M. Orth

Sunray

Company

COMPLETE

Contractor

NW SW NE

E. 1/2
SECTION PLAT

		0	

 Ft. from N. Line

990 Ft. from S. Line

 Ft. from E. Line

330 Ft. from W. Line

Rice County

Location

Rig up

Drilling and Remarks:

Stop 2458.

5" @ 2672

Pump 65 oil out

4/2/28

RECORD

Cased in., ft.

Sand

Gas

Oil

Total Depth 2680

PRODUCTION

1st 24 hrs. Nat.

1st 24 hrs. after shot

Gas Cu. Ft.

Dry Hole

Abandoned

Date

JUN 1 1948 19 S. J. LEWIS Scout