


Section 28 Township 18 Range 10WWell No. #1 HeinzCompany Anderson Prichard

NORTH

WEST

EAST

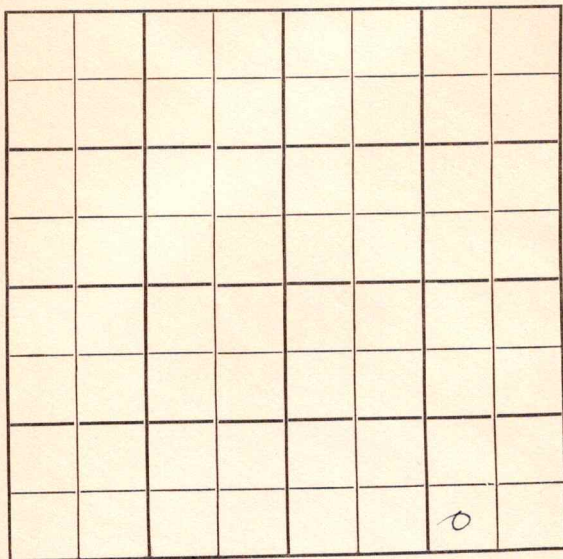

SOUTH

Rice

KANSAS

Sec. 28 Twp. 18 R. 10W

Well No. #1 Heinz Farm

Anderson-Prichard Company

Reserve Drlg. Contractor


Ft. from N. Line

330' Ft. from S. Line

990' Ft. from E. Line

Ft. from W. Line

SW SE SE

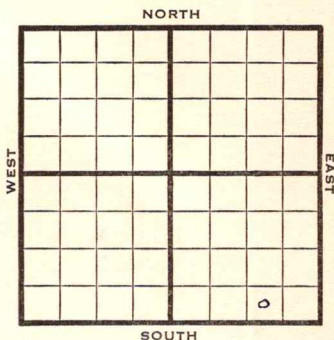

1950

REPORT

3/22

Spud 3-17-50
8-5/8" @ 273'
Anhy 440-65'
Drlg. 1628'

4/26

TD 3159'
8 5/8" @ 273
Anhy 440-65
Heebner 2720'
DST 2662-78
Rec 90' ocm
Br Lime 2837'
Lans 2854'
DST 2936-46
Rec 90' gcm
DST 2953-59
Rec 150' salt wtr.
DST 3124-45
Rec 90' oil & gas cut mud
TD 3145'
5"@ 3145'
DD 3149
FU 600' oil
Swab 1 boph
DD 3159
10 qt 3154-59
Swab 2 boph
Comp 52 BOPD
Comp


COMPI

1140523

Map No. _____ Sec. 28 Twp. 18 R. 10WWell No. 1 Heinz_____Anderson-Prichard_____
Company_____Reserve Drlg._____
Contractor

SW SE SE

SECTION PLAT

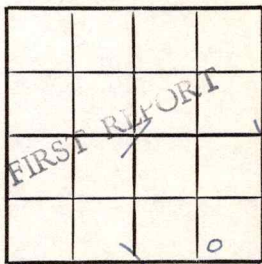_____Ft. from N. Line330 Ft. from S. Line990 Ft. from E. Line_____Ft. from W. LineRice CountySkelly farmout

Location _____

Rig up _____

Drilling and Remarks:

Spud 3-17-508 5/8" @ 273Anhy 440-65drlg. 1628

RECORD

Cased _____ in., _____ ft.

Sand _____

Gas _____

Oil _____

Total Depth _____

PRODUCTION

1st 24 hrs. Nat. _____

1st 24 hrs. after shot _____

Gas _____ Cu. Ft.

Dry Hole _____

Abandoned _____

Date

MAR 22 1950 19J. E. TYRA Scout

Kansas

Map No. _____ Sec. 28 Twp. 18 R. 10WWell No. 1 HeinzAnderson-Prichard Company

Contractor

SW SE SE


E1.1744
SECTION PLAT

_____ Ft. from N. Line

330 Ft. from S. Line990 Ft. from E. Line

_____ Ft. from W. Line

Rice County

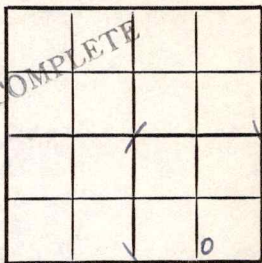

Location _____

Rig up _____

Drilling and Remarks:

8 5/8" C 273
 anky 440-65
 Heebner 2720
 DST 2662-78
 Rec. 90' ocm
 By line 2837
 Sans. 2854

RECORD

Cased _____ in., _____ ft.

Sand _____

Gas _____

Oil _____

Total Depth 3159

PRODUCTION

1st 24 hrs. Nat. _____

1st 24 hrs. after shot _____

Gas _____ Cu. Ft.

Dry Hole _____

Abandoned _____

Date

APR 26 1950 19

J. E. TYRA Scout

DST 2936-46

Rec. 90' gcm

DST 2953-59

Rec. 150' salt water

DST 3124-45

Rec. 90' oil + gas cut mud

T.D. 3145

5" C 3145

DD 3149

74 600' oil

Swab 1 bosh

DD 3159

10 qt. 3154-59

Swab 2 bosh

Comp. 52 bosh

Scout Cards
Land Small Map
Land Wall Map
Tracings
France Map
Pierce Map
Misc.

SECTION PLAT

CONTRACTOR

CONTRACTOR

WELL NO.

WELL NO.

FORM NO. 100 B.N. 11-40