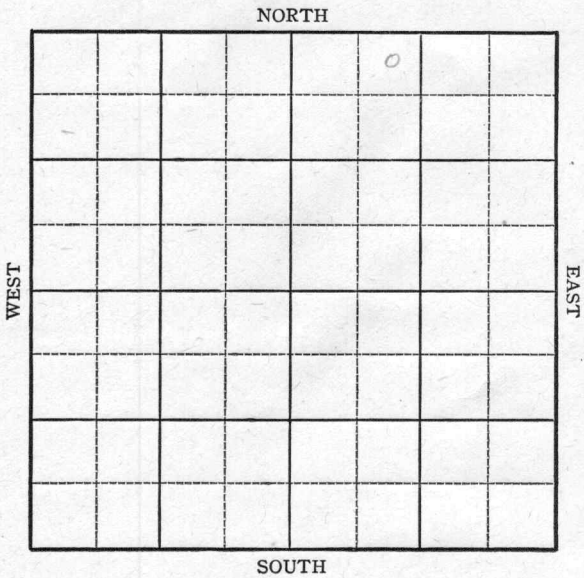


KANSAS

Summer

FORM 51 5M PETROL

Section 27 Township 32 Range 2EWell No. 1 Veail "B" # / BaileyCompany Nelson Drlg. etal

KANSAS


Summer

Sec. 27 Twp. 32 R. 2-E

Well No. #1 ~~Veal "B"~~ Bailey Farm

Nelson Drlg. etal Company

NORTH

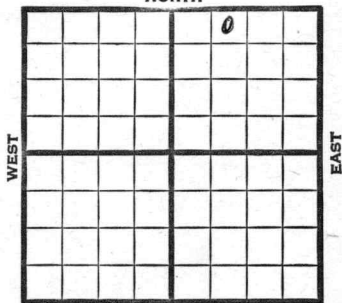

SOUTH

330 Ft. from N. Line

Ft. from S. Line

Ft. from E. Line

990 Ft. from W. Line

NE NW NE Elev. 1193

1945

REPORT

7/18 RUR
7/26 8" @ 157
Drlg. 2515
8/1 Lay 2750
Miss 3339
Drlg. 3383
8/8 TD 3712' PB
8/15 " " "
8/22 Miss. 3339
TD 3712'

ABANDONED

Kansas Pool Name Oxford

Map No. 7 Sec. 27 Twp. 32 R. 2 E

Well No. 1 Veail "A" B

Nelson Drlg. etal Company

FIRST REPORT Contractor

NE NW NE


SECTION PLAT

330 Ft. from N. Line

 Ft. from S. Line

 Ft. from E. Line

990 Ft. from W. Line

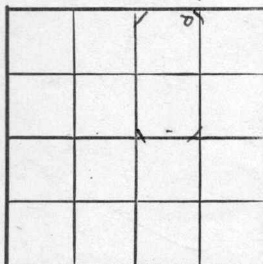

Sumner County

Location

Rig up

Drilling and Remarks:

RUR

RECORD

Cased in., ft.

Sand

Gas

Oil

Total Depth

PRODUCTION

1st 24 hrs. Nat.

1st 24 hrs. after shot

Gas Cu. Ft.

Dry Hole

Abandoned

Date

JUL 1 8 1945 19

S. J. LEWIS Scout

KANSAS

Kansas

Pool Name OxfordMap No. 1 Sec. 27 Twp. 32 R. 2EWell No. 1 BaileyNelson Drlg.


Company

CORRECTION

Contractor

NE NW NE

SECTION PLAT

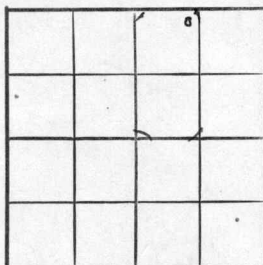330 Ft. from N. Line Ft. from S. Line Ft. from E. Line990 Ft. from W. Line

Sumner County

Location Rig up Drilling and Remarks:
reported #1 Veail "B"

RECORD

Cased in., ft.Sand Gas Oil Total Depth

PRODUCTION

1st 24 hrs. Nat. 1st 24 hrs. after shot Gas Cu. Ft.Dry Hole Abandoned

Date

AUG 1 1945 19S. J. LEWIS Scout

Kansas Pool Name Oxford

KANSAS
Map No. Sec. 27 Twp. 32 R. 2E

Well No. 1Bailey

Nelson Drlg. etal Company

ABANDONED Contractor

NE NW NE

E 11/193
SECTION PLAT

330 Ft. from N. Line

 Ft. from S. Line

 Ft. from E. Line

990 Ft. from W. Line

		8	

Sumner County

Location

Rig up

Drilling and Remarks:

Miss 3309

RECORD

Cased in., ft.

Sand

Gas

Oil

Total Depth 3512

PRODUCTION

1st 24 hrs. Nat.

1st 24 hrs. after shot

Gas Cu. Ft.

Dry Hole

Abandoned

Date

AUG 22 1945 19 S. J. LEWIS Scout