KANSAS

Form 51—5M—7-39—Palace


Rice

Section 28 Township 18 Range 10-W

Well No. #1 Heinz

Company Jones & Swain

Bredfeldt Pool

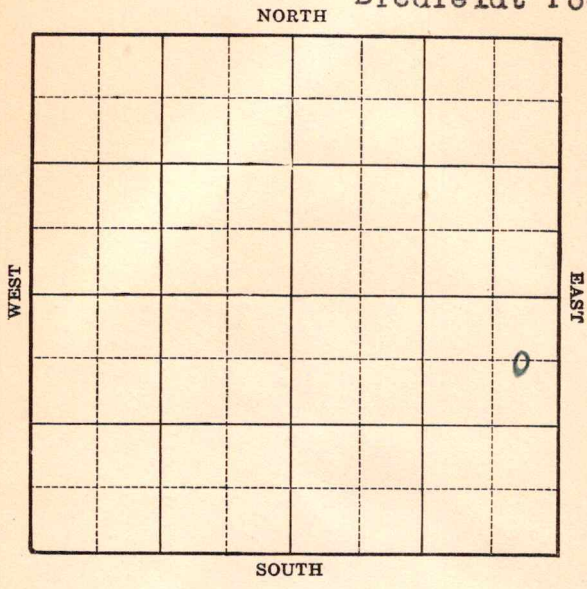

FORM 252-A 5M KANSAS Rice

Sec. 28 Twp. 18 R. 10-W

Well No. #1 Heinz Farm

Jones & Swain Company


(Bredfeldt)

660 Ft. from N. Line

Ft. from S. Line

330 Ft. from E. Line

Ft. from W. Line

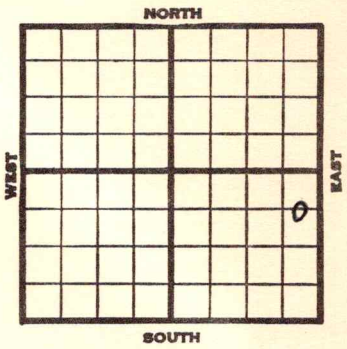

Elev. 1749

1940	REPORT
3/13	Location
3/21	"
3/28	"
4/4	"
4/12	"
4/18	Rotary.
4/25	"
5/2	10" - 182' Anhy 419'
	Drlg. 992'
5/9	Lans. 2920' Drlg. 3045'
5/15	Cong. 3227'
	Quartzite 3315'
	T.D. 3320' No shows.
	ABANDONED

Form 26—1M Bks.—2-29 Rice KANSAS

Map No. 55 Sec. 28 Twp. 18 R. 10W

Well No. 1 Heinz

Jones & Swain Company

Contractor

FIRST REPORT

C E L NE SE

660 Ft. from N. Line


Ft. from S. Line

330 Ft. from E. Line

Ft. from W. Line

BREDFELDT POOL

SECTION PLAT

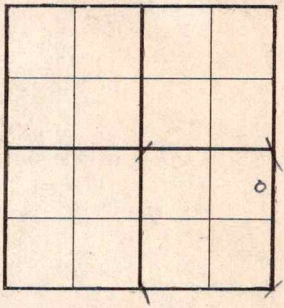

Location X

Rig up

Drilling and Remarks:

RECORD

Cased in., ft.

Sand

Gas

Oil

Total Depth

PRODUCTION

1st 24 hrs. Nat.

1st 24 hrs. after shot

Gas Cu. Ft.

Dry Hole

Abandoned

Date

MAR 13 1940

19

S. J. LEWIS Scout

Form 26—200 Bks.—1-40—Palace

KANSAS

Rice

Map No. 55 Sec. 28 Twp. 18 R. 10W

Well No. 1 Heinz

Jones & Swain Company

Contractor

ABANDONED

C E L NE SE

660 Ft. from N. Line


_____ Ft. from S. Line

330 Ft. from E. Line

_____ Ft. from W. Line

BREDFELDT POOL

SECTION PLAT

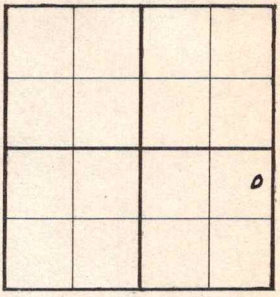

Location _____

Rig up _____

Drilling and Remarks:

Corg 3227
Lwr Tgte 3315
Nos hows

RECORD

Cased _____ in., _____ ft.

Sand _____

Gas _____

Oil _____

Total Depth 3320

PRODUCTION

1st 24 hrs. Nat. _____

1st 24 hrs. after shot _____

Gas _____ Cu. Ft.

Dry Hole _____

Abandoned _____

Date

MAY 15 1940 19

S. J. LEWIS Scout