


Section 26 Township 18 Range 10W

Well No. #6 Godfrey

Company Birmingham & Bartlett

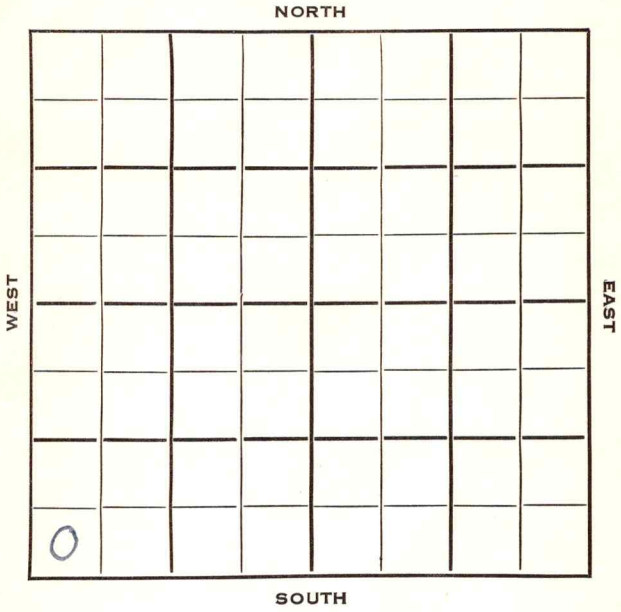

Rice

KANSAS ✓

Sec. 26 Twp. 18 R. 10 W

Well No. # 6 Godfrey Farm

Birmingham & Bartlett Company

B & B Contractor

Orth Pool


Ft. from N. Line

330 Ft. from S. Line

Ft. from E. Line

330 Ft. from W. Line

SW SW SW

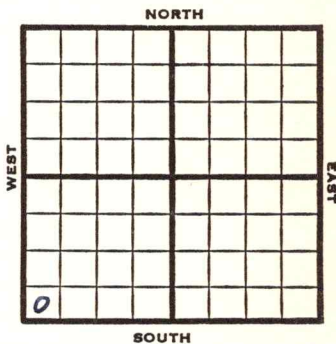

1953

Elev. 1746'

REPORT

5/6

MIR

5/20

Spud 5-5-53

D&A

T D 3257

8" @ 196

Anhy 435, Top 2476

DST 2674-2705, opn 1 hr., rec. 52' mud 730#

Heeb 2744, Br line 2866, Lans 2884,

Cong 3212

T D 3257

D&A

ABANDONED

