


KANSAS

Rice

Section 27 Township 18 Range 10 W

Well No. #1 Habiger

Company Musgrove Pet.
Orth Pool

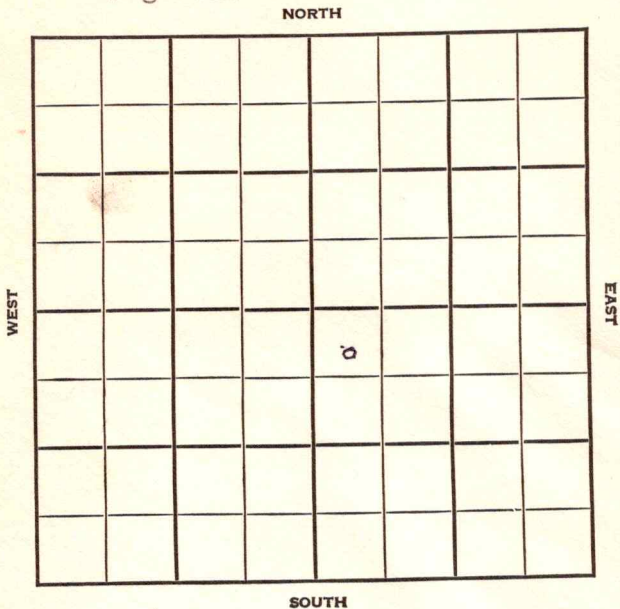

KANSAS

Rice

Sec. 27 Twp. 18 R. 10W

Well No. #1 Habiger Farm

Musgrove Pet. Company

Orth Pool


430' Ft. from N. Line

Ft. from S. Line

Ft. from E. Line

330' Ft. from W. Line

NW SE

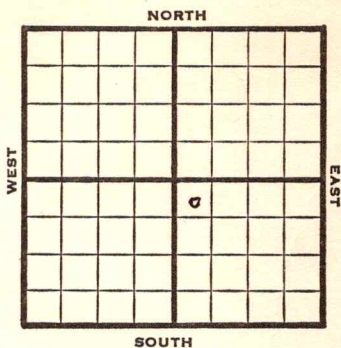

1948

E1 1749'

REPORT

5/26

RUR

6/1

8" @ 261'

6/16

"

6/23

TD 2680'

Topeka 2460'

5" @ 2657'

Pump 40 oil Pot

40⁹ Gr.

Comp.

COMPLETED

Map No. _____ Sec. 27 Twp. 18 R. 10W

Well No. 1 Habiger

Musgrove Pet. Company

FIRST REPORT Contractor

NW SE


SECTION PLAT

430 Ft. from N. Line

_____ Ft. from S. Line

_____ Ft. from E. Line

330 Ft. from W. Line

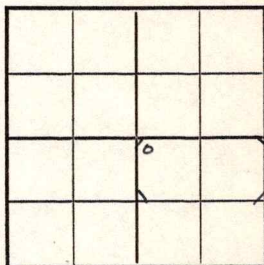

Rice County

Location _____

Rig up _____

Drilling and Remarks:

R U R

RECORD

Cased _____ in., _____ ft.

Sand _____

Gas _____

Oil _____

Total Depth _____

PRODUCTION

1st 24 hrs. Nat. _____

1st 24 hrs. after shot _____

Gas _____ Cu. Ft.

Dry Hole _____

Abandoned _____

Date

MAY 26 1948 19 S. J. LEWIS Scout

Kansas

Map No. 55 Sec. 27 Twp. 18 R. 10WWell No. 1 Habiger

Musgrove Pet.

Company

COMPLETE


Contractor

NW SE

E. 1749
SECTION PLAT430 Ft. from N. Line

Ft. from S. Line

Ft. from E. Line

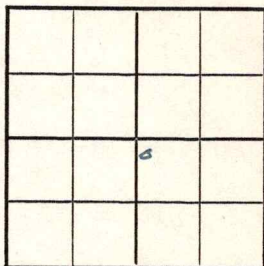330 Ft. from W. Line

Rice County

Location

Rig up

Drilling and Remarks:

Topoka 2460
5' @ 2657

Pump 40 oil Rd

40 9 1/2

RECORD

Cased _____ in., _____ ft.

Sand _____

Gas _____

Oil ☒ _____Total Depth 2657

PRODUCTION

1st 24 hrs. Nat. _____

1st 24 hrs. after shot _____

Gas _____ Cu. Ft.

Dry Hole _____

Abandoned _____

Date

JUN 23 1948

19

S. J. LEWIS Scout