


Section 28 Township 18 Range 10W

Well No. #1 Sittner

Company B & R Drlg.

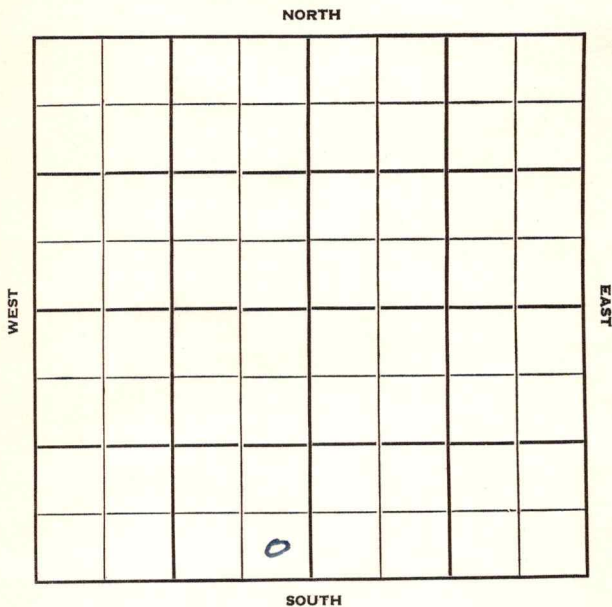

Rice

KANSAS ✓

Sec. 28 Twp. 18 R. 10W

Well No. #1 Sittner Farm

B & R Drlg. Company

B & R Drlg. Contractor


..... Ft. from N. Line

330' Ft. from S. Line

330' Ft. from E. Line

..... Ft. from W. Line

SE SE SW

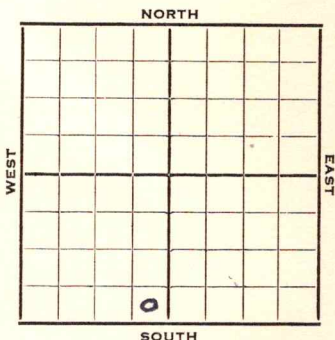

1952

Elev. 1737 REPORT

8/27

Spud 8-23-52
8" @ 270
Drlg. 479

9/3

Heeb. 2775 Tor 2798
Douglas 2811 Br Li 2900
Lans. 2918
DST 2932-51, 1 hr. 30'm
Drlg. 2985'

9/10

Spud 8-23-52 D&A TD 3343
8" @ 270 **Heeb. 2775 Tor. 2798**
Doug 2811 Br Lm 2900 Lans. 2918
DST 2932-51 opn 1hr. Rec. 30' mud
O# **Arb. 3319** TD 3343
D&A

ABANDONED

