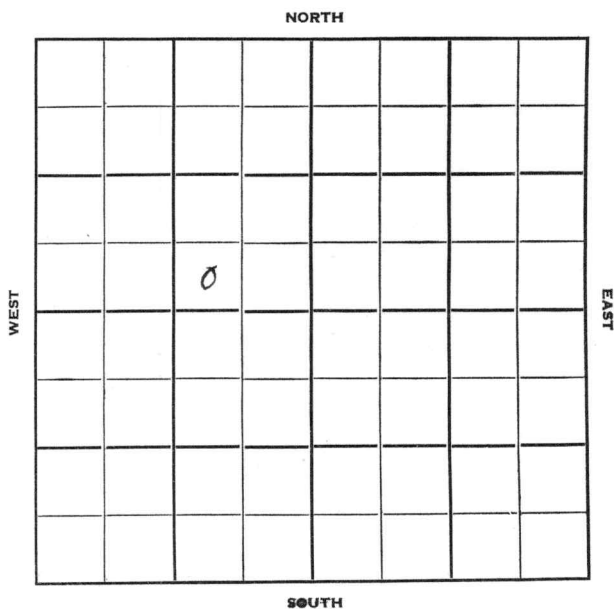


Section 31 Township 32 Range 2EWell No. #2 Barnett "B"Company McNish & Grallopp

Sumner

KANSAS

Sec. 31 Twp. 32 R. 2 E ✓

Well No. # 2 Barnett "B" Farm

McNish & Grallopp Company

Watson Contractor


 Ft. from N. Line

330 Ft. from S. Line

990 Ft. from E. Line

 Ft. from W. Line

SW SE NW

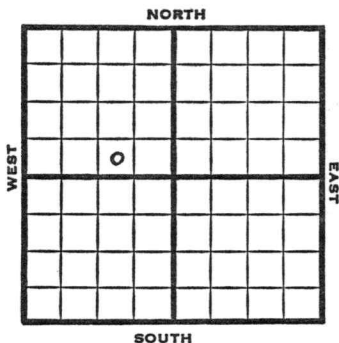

1951

Elev. 1660'

REPORT

2/7


Spud 2/1/51
8" @ 90'
Drlg. 1800'

2/28

Spud 2-1-51
D&A TD 3778
8" @ 90'
KC 2828 Miss 3390
Misenor 3724' Simp. 3729
Arb. 3772
D&A

ABANDONED

County Sumner State Kansas
 Sec. 31 (Blk.) 32 (Sur.) 2E Map No. (Twp.) (Rge.)
 Operator McNish & Grallop
 Well No. 2 Farm Barnett "B"
 Elev. 1660 Location SW SE NW

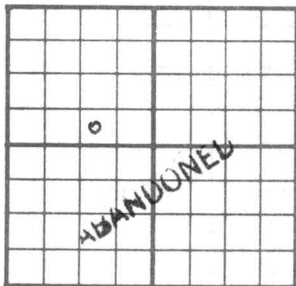

330 Ft. From S Line NW
990 Ft. From E Line Quarter

1st. Report

Completion FEB 22 1951

Remarks

Watson - Contr.

Spudding Date 2-1-51

Drlg. Data D & A TD 3778

8" @ 90 KC 2828 Miss. 3380

Misenor 3724 Simp. 3729 Arb. 3772-78 TD
D & A

J. E. TYRA