


Section 33 Township 32 Range 2E

Well No. #1 Lee

Company Coppitt Drlg.

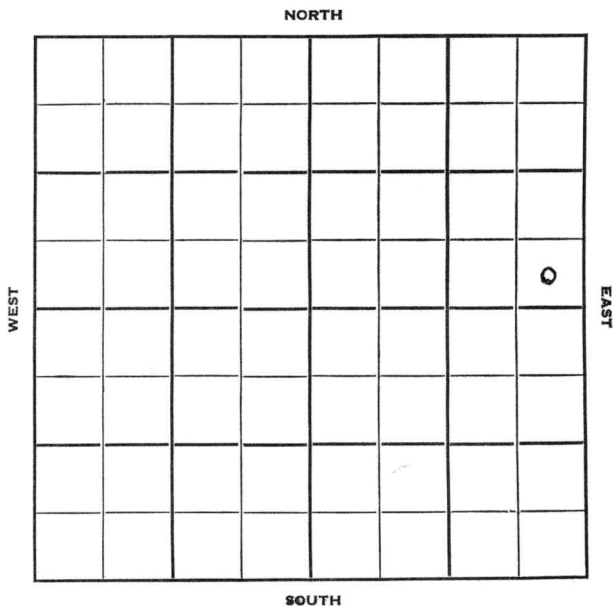

Sumner

KANSAS

Sec. 33 Twp. 32 R. 2E ✓

Well No. #1 Lee Farm

Coppitt Drlg. Company

Contractor

Wildcat


 Ft. from N. Line

330' Ft. from S. Line

330' Ft. from E. Line

 Ft. from W. Line

SE SE NE

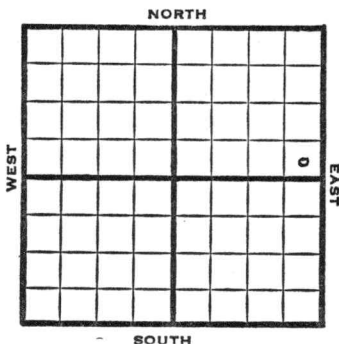

1951

Elev. 1185' REPORT

2/28

Location

Miss Strat

4/18

Spud 3-14-51

Oil Well TD 3358

8" @ 80

Layton 2780 KC 2829

Miss 3349

5" @ 3350 TD 3358

S/1½ boph Comp. 25 bopd

COMPLETED

