


Section 26 Township 18 Range 10WWell No. #5 GodfreyCompany B & B Drlg.

NORTH

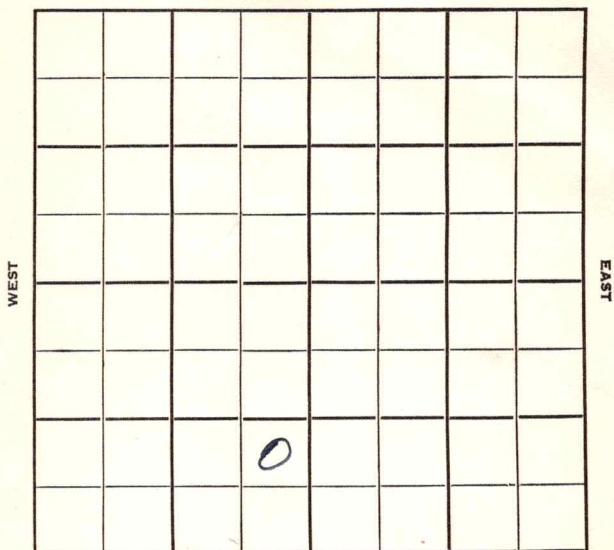

SOUTH

Rice

KANSAS

Sec. 26 Twp. 18 R. 10W

Well No. #5 Godfrey Farm

B & B Drlg. Company

B & B Drlg. Contractor

Orth Pool


Ft. from N. Line

990 Ft. from S. Line

330 Ft. from E. Line

Ft. from W. Line

NE SE SW

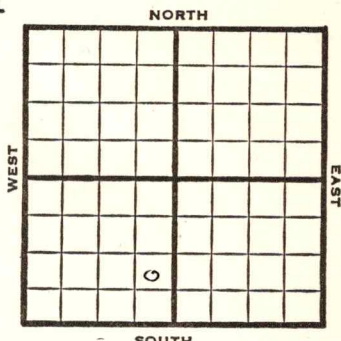

1952

Elev. 1753'

REPORT

1/2

Spud 12-27-51

8" @ 189'

Anhy 420'

Drlg. 2150'

2/6

Spud 12-27-51

Oil Well TD 3273

8" @ 189

Anhy 420

Top. 2486

Heeb. 2758

Br Li 2862

Lans. 2878

Arb. 3241

TD 3248 5" @ 3244 DD 3249

dry 500 A DD 3273 FU 300' oil

2 hr. S/ 2 boph

Comp. 30 bopd 6% wtr.

COMPLETED

County **Rice** State **Kansas**

Sec. 26 (Blk. Twp.) 18 (Sur. Rge.) 10W Map No.

Operator B & B Drlg.

Well No. 5 Farm Godfrey

Elev.	Location	NE SE SW
-------	----------	-----------------

FIRST REPORT

990 Ft. From S Line SW

330 Ft. From E Line Quarter

1st. Report **JAN 2 1952**

Completion

Remarks

B & B Drlg. - Contr.

Spudding Date 12-27-51

Drlg. Data Orth Pool

8" @ 189 Anhy 420 drlg. 2150

County Rice State Kansas
 Sec. 26 (Blk.) 18 (Sur.) 10W Map No.
 Operator B & B Drlg.
 Well No. 5 Farm Godfrey
 Elev. 1753 Location NE SE SW

990 Ft. From S Line SW
 330 Ft. From E Line Quarter
 Ist. Report
 Completion FEB 6 1952
 Remarks Orth Pool
B & B Drlg. - Contr.
 Spudding Date 12-27-51

Drlg. Data Oil well TD 3273
8" @ 189 Anhy 420 Top. 2486
Heeb. 2758 Br. lime 2862 Lans. 2878
Arb. 3241 TD 3248 5" @ 3244 DD 3249
dry 500 A DD 3273 FU 300' oil 2 hr.
S/ 2 boph Comp. 30 bopd 6% water