


Sumner

SECTION 33 TOWNSHIP 32 RANGE 2E

WELL NO. #1 Wright

COMPANY Shawver-Armour

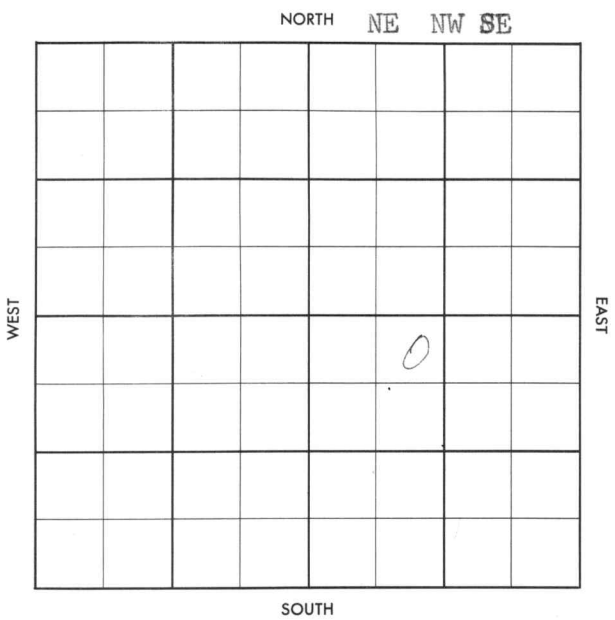

# WILDCAT

FORM 513 SUNRAY

County Summer Elev. \_\_\_\_\_  
 Sec. 33 Twp. 32 Rge. 2E  
 Company Shawyer-Armour  
 Farm Name Wright No. 1

TOPS	DEPTH	LOG	DATUM	Loc. in Sec.
Anh.				NE NW SE
Tr.				
H.				
Dg.				
Bl.				Geol. _____
L.				Contr. _____
K.C.				Co. tools
B.K.C.				
Ce.				Pool
C.				
M.				Wildcat
M.				
K.				FIRST REPORT
Mz.				
Me.				
V.				
S.				MAR 20 '57
S.				
A.				
R.				
PE.				
G.				
T.D.				

Date Comm. 3-16-57  
8" @ 100/100 drlg. 1160

~~29~~

Co.  
Lse.  
No.  
Sec.  
T.  
R.

County Sumner Elev. 1181  
 Sec. 33 Twp. 32 Rge. 2E  
 Company Shawver Armour  
 Farm Name Wright No. 1

TOPS	DEPTH	LOG	DATUM
Anh.			
Tp. <u>Stall</u>	<u>2355</u>		
H.			
Tr.			
Dg.			
Bl.			
L.			
K.C.			
B.K.C.			
Ce.			
C.			
M.	<u>3350</u>		
M.			
K.			
Mz.			
Ma.			
V.			
S.			
S.			
A.			
R.			
PE.			
G.			
TD.	<u>3374</u>		

Loc. in Sec. NE NW SE  
 Geol. \_\_\_\_\_  
 Contr. Co. tools  
 Pool Wildcat

COMPLETE  
 APR 17 '57

Date Comm. 3-16-57

8" @ 100/100 drlg. 1760 MAY 27 57  
 # 3260 APR 3 57 DST 3353-74  
 op 2 hrs see 760' GIP  
 +100' HOCM + 30' oily wt  
 BHP 500 5 1/2 @ 3353 / 47 10 57  
 APR 17 57 CO 3356 FRAC 3 X 3  
 P. 10 Bopd + 20 BWpd

Co. Lse. No. Sec. T. R.