


Rice

Map No. KANSAS Sec. 27 Twp. 18 R. 10^W

Well No. 1 Harbiger Farm
Slick Pryor & Lockhart Company

330' Ft. from N. Line
____ Ft. from S. Line
____ Ft. from E. Line
990' Ft. from W. Line

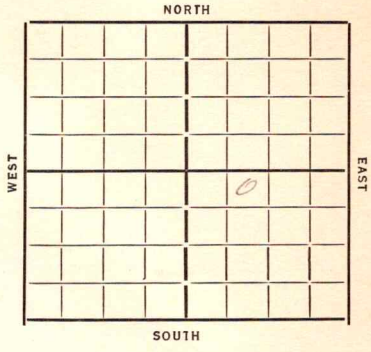

Date	REPORT
12/6	Material
12/12	Wellar
12/27	Spudding
1/11	Show gas 1420-30 - H.F.W 1435 Drlg 1545
1/17	10" at 1783 Show oil 2040-50 Drlg 2225
1/24	8" at 2480 Show oil 2682-96 6" at 2902 Drlg 2907
1/31	6" 2997 drlg 3140
2/19	Cong. 3190 show oil 3236 5" 3234 TD 3242 2800 oil 8 hrs
2/14	Cong. 3190 TD 3242 336 Bbls.
	COMPLETED

Map No. 55 Sec. 27 Twp. 18 R. 10N

Well No. 1-Habiger

Slick, Pryor & Lockhart Company

Contractor

COMPLETED

SECTION PLAT

330 Ft. from N. Line

..... Ft. from S. Line

..... Ft. from E. Line

990 Ft. from W. Line

		0	

Location.....

Rig up.....

Drilling and Remarks:

336
bbls

RECORD

Cased..... in..... ft.

Sand cong 3170

Gas.....

Oil.....

Total Depth 3242

PRODUCTION

1st 24 hrs. Nat.....

1st 24 hrs. after shot.....

Gas..... Cu. Ft.

Dry Hole.....

Abandoned.....

Date

2-14-34 192 O. Manschreck Scout

Map No. 55 Sec. 27 Twp. 18 R. 10W

Well No. 1- Habiger

Slick, Ryan & Lockhart Company

Contractor

SECTION PLAT

		○	

330 Ft. from N. Line

..... Ft. from S. Line

..... Ft. from E. Line

990 Ft. from W. Line

FIRST REPORTS

Location.....

Rig up.....

Drilling and Remarks:

material

RECORD

Cased.....in.,ft.

Sand.....

Gas.....

Oil.....

Total Depth.....

PRODUCTION

1st 24 hrs. Nat.....

1st 24 hrs. after shot.....

Gas.....Cu. Ft.

Dry Hole.....

Abandoned.....

Date

12-6-33 192 O. Mannschuck Scout