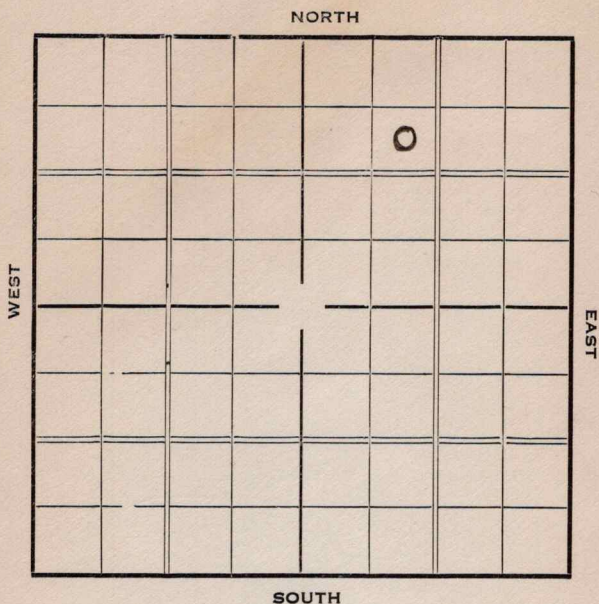



Section 33 Township 13 Range 14-WWell Number 4 Boxberger (Henry)Company Skelly Oil

KANSAS

Russell

Sec. 33 Twp. 13 R. 14-WWell No. #4 Boxberger (Henry) FarmSkelly Oil Company990 Ft. from N. Line Ft. from S. Line Ft. from E. Line990 Ft. from W. Line

Elev. 1864

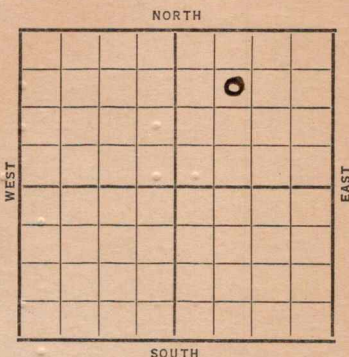

Date	REPORT
1937	
4/14	Location
4/23	Rig
4/30	Spud 70'.
5/7	15" @ 400'. Drlg. 430'.
5/14	12" @ 595'. Anhy 898'.
	10" @ 898'. Drlg. 1205'.
5/21	Drlg. 2025'.
5/28	8" @ 2280'. Drlg. 2360'.
6/4	8" @ 2540'. T.D. 2580'.
	U.R. 8".
6/11	S.O. 2730'. 8" @ 2750'.
	Topaka 2755'. Drlg. 2881'.
6/19	Osw. 3037'. 7" @ 3100'.
	T.D. 3125'. Lowering 7".
6/25	Sil. 3281'. 7" @ 3283'.
	T.D. 3284'. WOC.
7/2	T.D. 3292½'. 2000 acid.
7/9	T.D. 3296½'. H.F.O.
	OVER

735471

1937

7/14

7" @ 3283'.

Sil. 3281'.

T.D. 3296 $\frac{1}{2}$ '.

2000 acid.

Pump 378 bbls. 15 hrs.

P.B. 3292'.

2000 acid.

Pot. 930 bbls.

COMPLETED

KANSAS *Russell*Map No. _____ Sec. *33* Twp. *13* R. *14W*Well No. *4 Boxberger**Shelly Oil* Company

Contractor _____

SECTION PLAT

		o	

990 Ft. from N. Line

_____ Ft. from S. Line

_____ Ft. from E. Line

990 Ft. from W. Line**FIRST REPORT**Location *✓* _____

Rig up _____

Drilling and Remarks:

RECORD

Cased _____ in., _____ ft.

Sand _____

Gas _____

Oil _____

Total Depth _____

PRODUCTION

1st 24 hrs. Nat. _____

1st 24 hrs. after shot _____

Gas _____ Cu. Ft.

Dry Hole _____

Abandoned _____

Date

APR 14 1937 19

S. J. LEWIS

Scout

Russell KANSAS

Map No. _____ Sec. 33 Twp. 13 R. 14^wWell No. 4 - BoxbergerSkelly Company

Contractor _____

COMPLETED

990 Ft. from N. Line

_____ Ft. from S. Line

_____ Ft. from E. Line

990 Ft. from W. Line

SECTION PLAT

		0	

Location _____

Rig up _____

Drilling and Remarks:

2000 Acid
Pump 378/15 hrsP.B. 32922000 AcidPot 930

RECORD

Cased 7 in., 3283 ft.~~Sand~~ 511 3281

Gas _____

Oil _____

Total Depth 3296 $\frac{1}{2}$

PRODUCTION

1st 24 hrs. Nat. _____

1st 24 hrs. after shot _____

Gas _____ Cu. Ft.

Dry Hole _____

Abandoned _____

Date

JUL 14 1937 19H. D. Hatfield Scout