


Map No. KANSAS Sec. 8 Twp. 15 R. 14^W
Well No. 1-Mare
Allison - Fitz Williams Farm
Company

NORTH

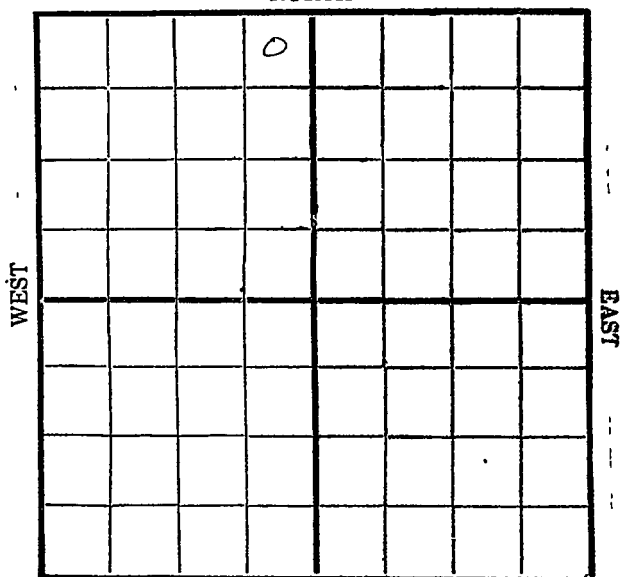

SOUTH

Location _____

Drilling Remarks

RECORD

Cased _____ in. _____ ft.
Sand _____
Gas _____
Oil _____
Total Depth _____

Rig Up _____

Drilling Remarks

PRODUCTION


1st 24 hrs. Nat. _____
1st 24 hrs. after shot _____
Gas _____ cu. ft. _____
Dry Hole _____
Abandoned _____

Map No. KANSAS Sec. 8 Twp. 15 R. 14^w

Well No. 1- Mave Farm Chal

Allison - Fitzwilliams Company

NORTH

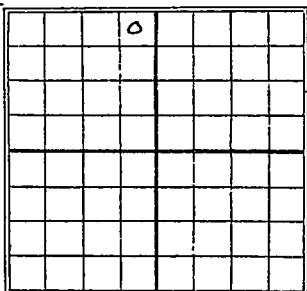

WEST

EAST

SOUTH

330 Ft. from N. Line

_____ Ft. from S. Line

330 Ft. from E. Line

_____ Ft. from W. Line

Date

REPORT

12/18 Location

12/23 —

12/30 —

1930 Bldg. Rig

1/8 Rig

1/15 —

1/22 —

1/29 —

2/5 Drilg 400'

2/12 " 650

2/19 " 1100

2/26 " 1600

3/5 " 1900'

3/12 " 1900'

3/19 S.D. 1900'

3/26 Slg. out 1910'

4/2 —

4/9 hrlg. 2475'

4/16 " 2675'

4/23 " 2775'

4/30 " 3022'

5/7 - Hrlg. 3030'

5/14 - " 3131' show
oil 3100-05'

5/21 - Pay 3268-72
Swabbed 9.5 bbls 18
hrs. U.R. 6"-3240'

5/28 - No report

6/4 - 3272 equals 3280
(S.L.M.). 6"-3243.
Hrlg. 3290'

6/11 - Top Silc. line
3308 - N7W 3317-
25 T.D. - P.B.

6/18 - P.B. to 3294 S.D.

6/25 - Sand 3268-72'
TD 3294
Swab 60 bbl oil
Comp.

Russell
 Map No. **KANSAS** Sec. *8* Twp. *15* R. *14 W*

75
 Well No. *1 Maire*

Allison & Fitzwilliams & *846*
 Company

Contractor

SECTION PLAT

320 Ft. from N. Line

.....Ft. from S. Line

320 Ft. from E. Line

.....Ft. from W. Line

	<i>0</i>		

LATEST REPORTS

Location *✓*

Rig up

Drilling and Remarks:

RECORD

Cased.....in.,ft.

Sand.....

Gas.....

Oil.....

Total Depth.....

PRODUCTION

1st 24 hrs. Nat.....

1st 24 hrs. after shot.....

Gas.....Cu. Ft.

Dry Hole.....

Abandoned.....

Date

DEC 18 1929 *192*..... *S. J. LEWIS* Scout

Map No. KANSAS Sec. 8 Twp. 15 R. 14WWell No. 1 MainAllison & Fitzwilliams Eds Company

Contractor

SECTION PLAT

	0		

330 Ft. from N. Line

_____ Ft. from S. Line

330 Ft. from E. Line

_____ Ft. from W. Line

COMPLETED

Location _____

Rig up _____

Drilling and Remarks:--

swath 60 ft

RECORD

Cased _____ in., _____ ft.

Sand 9268-72

Gas _____

Oil ☒Total Depth 9294

PRODUCTION

1st 24 hrs. Nat. _____

1st 24 hrs. after shot _____

Gas _____ Cu. Ft.

Dry Hole _____

Abandoned _____

Date

JUN 25 1930S. J. LEWIS

Scout