


KANSAS

Russell

Section 25 Township 14 Range 13-WWell No. #1 Ruby EstateCompany Magnolia

(Hall Gurney) NORTH

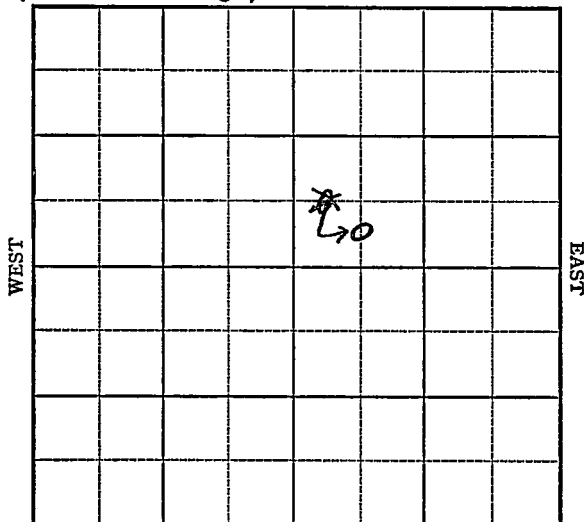

SOUTH

1942

1/28

Lans. 2865'

5" - 3148'

Arb. 3148'

T.D. 3153'

P.B. to 2873'

36 shots 2811-17'

3000 acid.

Water.

ABANDONED

Map No. 72 Sec. 25 Twp. 14 R. 13WWell No. 1 Ruby EstateMagnolia Company


FIRST REPORT

Contractor

C WL SW NE

 Ft. from N. Line660 Ft. from S. Line Ft. from E. Line330 Ft. from W. Line

SECTION PLAT

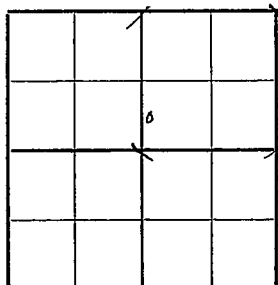

HALL GURNEY POOL

Location XXRig up

Drilling and Remarks:

RECORD

Cased in., ft.Sand Gas Oil Total Depth

PRODUCTION

1st 24 hrs. Nat. 1st 24 hrs. after shot Gas Cu. Ft.Dry Hole Abandoned

Date

DEC 1 0 1941 19S. J. LEWIS

Scout

KANSAS

Russell

Map No. 72 Sec. 25 Twp. 14 R. 13WWell No. 1 Ruby EstateMagnolia

Company

Contractor

C SL SW NE

Ft. from N. Line

330 Ft. from S. Line

Ft. from E. Line

660 Ft. from W. Line

SECTION PLAT

		o	

WILDCA T

Location

Rig up

Drilling and Remarks:

Reported

C WL SW NE

RECORD

Cased _____ in., _____ ft.

Sand _____

Gas _____

Oil _____

Total Depth _____

PRODUCTION

1st 24 hrs. Nat. _____

1st 24 hrs. after shot _____

Gas _____ Cu. Ft.

Dry Hole _____

Abandoned _____

Date

DEC 23 1941

19

S. J. LEWIS Scout

Map No. 72 Sec. 25 Twp. 14 R. 13WWell No. 1 Ruby EstateMagnolia CompanyABANDONED Contractor

C SL SW NE

 Ft. from N. Line330 Ft. from S. Line Ft. from E. Line660 Ft. from W. Line

SECTION PLAT

WILDCAT

Location Rig up

Drilling and Remarks:

*Lease 2865.**5" C 3148**CR Y 3148.**PB 2873**364 h to 2811-17**3000 acial**Water.*

RECORD

Cased in., ft.Sand Gas Oil Total Depth 3153

PRODUCTION

1st 24 hrs. Nat. 1st 24 hrs. after shot Gas Cu. Ft.Dry Hole Abandoned

Date

JAN 28 1942 19 S. J. LEWIS Scout