

KANSAS

Barber

Section 20 Township 30 Range 15-W

Well No. #2 National Gypsum

Company Ed Berry
Nadel & Gussman

Turkey Creek

NORTH

NENWSE

WEST

EAST

					0		

SOUTH

Barber

KANSAS

Sec. 20 Twp. 30 R. 15W ✓

Well No. #2 National Gypsum Farm

Nadel & Gussman Company

Reserve Drlg. Contractor

Turkey Creek


330' Ft. from N. Line

Ft. from S. Line

Ft. from E. Line

990' Ft. from W. Line

NE NW SE

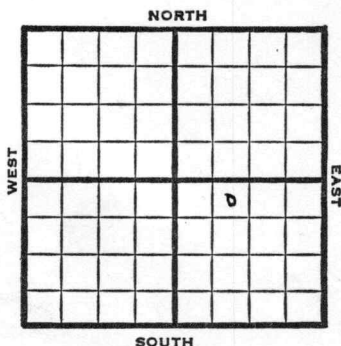

1950

Elev 1839

REPORT

3/8 Spud 3-6-50

10" @ 840'

WOC

4/26

TD 4532'

10" @ 840'

Br Line 3965'

Lans 3586'

DST 4435-55'

Rec 8' mud

DST 4402-35

Rec 180' gcm

5" @ 4502'

Miss 4518-20 NS

PB 4450

35/44/18-28

Bailll boph

5000 A

TD 4532'

Comp 50 bopd

No wtr.

Comp

COMPLETED

Map No. _____ Sec. 20 Twp. 30 R. 15WWell No. 2 National GypsumNadel & Gussman CompanyReserve Drlg. Contractor

NE NW SE

SECTION PLAT

330 Ft. from N. Line

_____ Ft. from S. Line

_____ Ft. from E. Line

990 Ft. from W. LineBarber County

Location _____

Rig up _____

Drilling and Remarks:

Spud 3-6-50

10" @ 840

WOC

RECORD

Cased _____ in., _____ ft.

Sand _____

Gas _____

Oil _____

Total Depth _____

PRODUCTION

1st 24 hrs. Nat. _____

1st 24 hrs. after shot _____

Gas _____ Cu. Ft.

Dry Hole _____

Abandoned _____

Date

MAR 8 1950

19

J. E. TYRA Scout

Kansas

Turkey Creek

Map No. _____ Sec. 20 Twp. 30 R. 15WWell No. 2 National GypsumNadel & Gussman

Company

Contractor

NE NW SE

E-1.1839
SECTION PLAT330

Ft. from N. Line

Ft. from S. Line

Ft. from E. Line

990

Ft. from W. Line

		0	

Barber County

Location _____

Rig up _____

Drilling and Remarks:

10" e 840
Br line 3965
Lans. 3586
DST 4435-55
Rec. 8' mud
DST 4402-35

RECORD

Cased _____ in., _____ ft.

Sand _____

Gas _____

Oil _____

Total Depth 4532

PRODUCTION

1st 24 hrs. Nat. _____

1st 24 hrs. after shot _____

Gas _____ Cu. Ft.

Dry Hole _____

Abandoned _____

Date

APR 26 1950 19

J. E. TYRA

Scout

Rec. 180' gem

5" @ 4502

Misc. 4518-20 NS

PB 4450

35/ 4418-28

Bail 1 bop

5000 A

T.D. 4532

Comp. 50 bop no water

Scout Cards	
Land Small Map	
Land Wall Map	
Tracings	
France Map	
Pierce Map	
Misc.	

John

15

MAY 1951

Well No

Map No

Sec

Twp

R

~~Top~~ ~~Pool~~
~~O.W.W.O.~~

County Barber Elev. 1839 DF
 Sec. 20 Twp. 30S Rge. 15W
 Company Ed Berry
 Farm Name National Gypsum No. 2

TOPS	DEPTH	LOG	DATUM
Anh.	700		
Tp.			
H.			
Tr.			
Dg.			
B.L.			
L.	3986		
K.C.			
B.K.C.			
Ce.			
xx Massey	4410		
M.	4518		
M.			
K.			
Mz.			
Mq.			
V.			
S.			
S.			
A.			
R.			
Pf.			
G.			
OTD	4520		
T.D.			

Loc. in Sec. NE NW SE
(O.W.W.O.)
O.W.W.O.
 Geol. Signal Oil
 Contr. Field Service
 Pool Turkey Creek



Date Comm. OLD INFO: Was Nadel-Gussman,
5" @ 4502, Tops.

NEW INFO: RUCT Sq all perfs drilled plug,
DD C 4561 to test Viola

Co.

Lse

No.

Sec.

T.

R.

~~O.W.W.O.~~
~~Twp. Pool.~~
~~Co. Facet.~~

S-513-B

County Barber Elev. 1839 DF
 Sec. 20 Twp. 30S Rge. 15E
 Company Ed Berry
 Farm Name National Gypsum No. 2

TOPS	DEPTH	LOG	DATUM	Loc. in Sec.
Anh.	700			NE NW SE
Tp.				(O.W.W.O.)
H.				O.W.W.O.
Tr.				Geol.
Dg.				Contr. Signal Oil
B.L.				Field Service
L.	3986			Pool
K.C.				Turkey Creek
B.K.C.				ABANDONED
Ce.				
EX Massey	4110			
M.	4518			
M.				
K.				
Mz.				
Mq.				
V.	4629			
S.				
S.				
A.				
R.				
Pf.				
G.				
OTD	4520			
T.D.				

Date Comm. OLD INFO: Was Nadel-Gussman,
5" @ 4502, Tops.

NEW INFO: RUCT Sq all perfs drilled plug,
DD C 4561 to test Viola JUL 23 '58 Co 4637

JUL 30 '58 TD 4637 4 1/2" Liner 4577
4627 Co 4637 (1/2) @ 100'w
550

D & A