


Map No. KANSAS Sec. 21 Twp. 14 R. 13W

Well No. ~~#37~~ Sherwood Farm

~~Company~~ Company

Lewis Hai
O.W.W.O.

NORTH

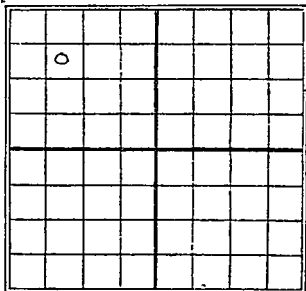

990 Ft. from N. Line

_____ Ft. from S. Line

_____ Ft. from E. Line

990 Ft. from W. Line

1030 SE NW NW

SOUTH

Date 26th Sep 1893 REPORT

9/10	2 oc.
9/17	Bldy rug
9/24	Runny
10/1	10' lg 340'
10/8	" 735'
10/15	" 1680'
10/22	Show oil 2330-35
	dry 2380'
10/29	8" 2393
	dry 2785'
11/5	" 3165'
11/12	Run 5" - 3240'
11/19	Of sq tools 3278'
11/25	4/10 5" - 3278'
12/3	HF Wat 3240'
	T.D. 3332
	Dry & Abandon

OVER

O.W.W.O.

1952

4/16

Lans. 2960 Gorham 3285.

OTD 3332 D&A

Cellar & Pits to CO & test Tarkio

4/23

"

4/30

Anhy 745 Ft. Riley 1675

Topeka 2635 Arb. 3240

Reagan 3284

5/7

NR

5/14

NR

5/21

"

5/28

"

6/11

"

6/18

"

6/25

Abd. TD 3284

Lans. 2960

Gorham 3285

OTD 3322

Anhy 745

Ft. Riley 1675

Top. 2635

Re Arb. 3240

Regan 3284

Abd. operation

ABANDONED

O.W.W.O.

1953

8/5

Lans 2960, Gorham 3285

OTD 3332

CO to 2452

5" @ 2452, WOC

9/2

D&A

TD 3332

Lans 2960, Gorham 3285

OTD 3332

CO to 2452

5" @ 2452

6/2341-42, gas, FU 4 bo 5 bw 14 hs.

PB 2335, perf/2319-20 gas 4 bo 5 bw

14 hrs.

CO to 2349

20/2340-42

D&A

ABANDONED

Map No. _____ Sec. 21 Twp. 14 R. 13W

Well No. 3 Sherwood

Lewis Mai Company

CORRECTION

Contractor

SE NW NW OWWO

SECTION PLAT

990 Ft. from N. Line

_____ Ft. from S. Line

_____ Ft. from E. Line

990 Ft. from W. Line

b			

Russell County

Location _____

Rig up _____

Drilling and Remarks:

Reported
#2 Sherwood

RECORD

Cased _____ in., _____ ft.

Sand _____

Gas _____

Oil _____

Total Depth _____

PRODUCTION

1st 24 hrs. Nat. _____

1st 24 hrs. after shot _____

Gas _____ Cu. Ft.

Dry Hole _____

Abandoned _____

Date

AUG 12 1953

J. G. MCGEHEE

Scout

County Russell State Kansas

Sec. 21 (Blk. Twp.) 14 (Sur. Rge.) 13W Map No.

Operator Lewis Mai (was CSO)

Well No. 2 Farm Sherwood

Elev. 1803 Location SE NW NW

	0						

ABANDONED

990 Ft. From N Line NW

990 Ft. From W Line Quarter

1st. Report

Completion JUN 25 1952

Remarks Hall-Gurney Pool

Spudding Date O.W.W.O.

Drig. Data Abd. TD 3284

Lans. 2960 Gorham 3285 OTD 3322

Anhy 745 Ft. Riley 1675 Top. 2635

ReArb. 3240 Regan 3284

Abd. operation

Map No. **KANSAS** Sec. 21 Twp. 14 R. APW

Well No. 72 1 Greenwood

Empire Oil Ref. Company

Contractor

SECTION PLAT

990 Ft. from N. Line

..... Ft. from S. Line

..... Ft. from E. Line

990 Ft. from W. Line

0			

FIRST REPORTS

Location ✓

Rig up

Drilling and Remarks:

RECORD

Cased in., ft.

Sand

Gas

Oil

Total Depth

PRODUCTION

1st 24 hrs. Nat.

1st 24 hrs. after shot

Gas Cu. Ft.

Dry Hole

Abandoned

Date

SEP 10 1930 192

S. I. LEWIS Scout

Russell
 Map No. **KANSAS** Sec. *21* Twp. *14* R. *13 W.*
 Well No. *72* *Sheswood*
Empire O & Ref. Company
 Contractor

SECTION PLAT

990 Ft. from N. Line
 Ft. from S. Line
 Ft. from E. Line
990 Ft. from W. Line

0			

ABANDONED

Location.....

Rig up.....

Drilling and Remarks:

HLWB 240

RECORD

Cased.....in.,ft.

Sand.....

Gas.....

Oil.....

Total Depth *3332*

PRODUCTION

1st 24 hrs. Nat.....

1st 24 hrs. after shot.....

Gas.....Cu. Ft.

Dry Hole.....

Abandoned.....

Date

DEC 3 1936 *S. J. LEWIS* Scout