

KANSAS

Russell


FORM 51 5M PETROL

Section 34 Township 13 Range 14W

Well No. #1 Bertha Wolf

Company Black-Marshall

Russell Pool

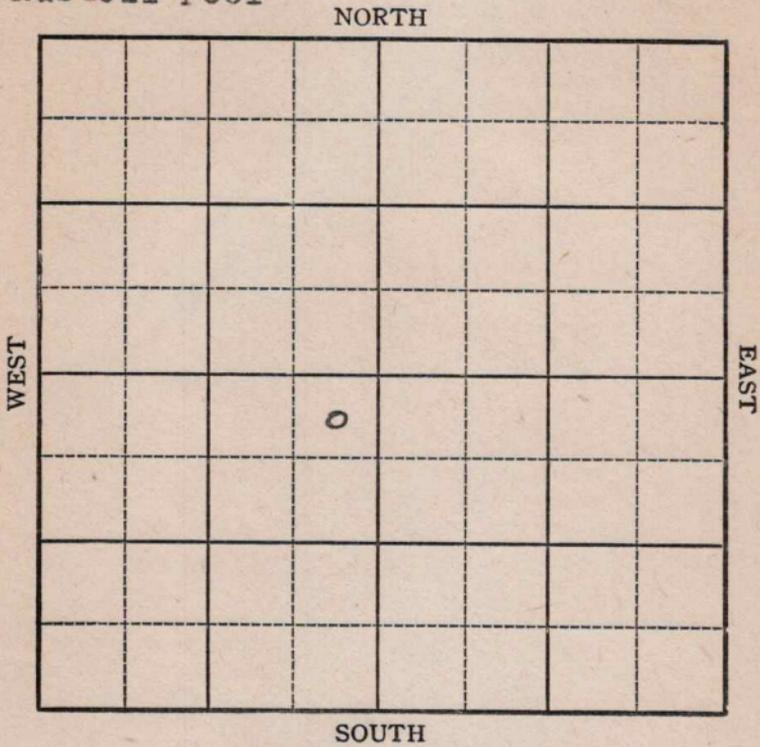

Sec. 34 Twp. 13 R. 14W

Well No. #1 Bertha Wolf Farm

Black-Marshall Company


330 Ft. from N. Line

_____ Ft. from S. Line

330 Ft. from E. Line

_____ Ft. from W. Line

Elev. 1838

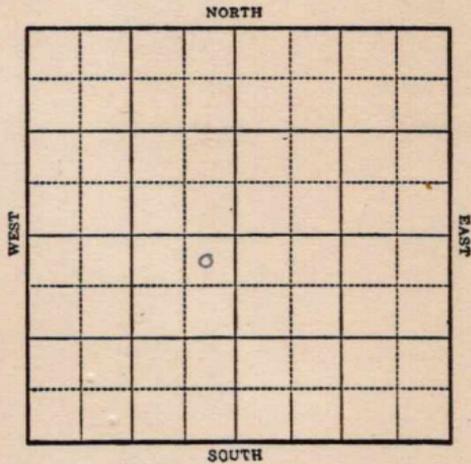

1943	R E P O R T
12-22	Cable rig
12/29	"
1944	
1-5	Rigging up
1-12	"
1/19	"
1/26	20" @ 30 310 fsg.
2/2	15" @ 337 12" @ 535 Drlg. 735
2/8	10" @ 857 Anhy 857 Drlg. 1816
2/15	8" @ 2515 Drlg. 2730'
2/23	Lans 3010 7" @ 3012 Drlg 31800'
3/1	Cong 3270 Gorham 3289 TD 3290 5" @ 3290
3/8	WOC TD 3293 1700' oil in 5 hrs.

OVER

735522

1944

3/16 Rigging up to drill deeper.

3/22 T^U 3294'

3/29 5" @ 3290

Gorham 3289

TD 3294

Pump 50 Pot.

Gravity 36.3

COMPLETED

KANSAS

Map No. 72 Sec. 34 Twp. 13 R. 14W

Well No. 1 Bertha Wolf

Black-Marshall

Company

FIRST REPORT

Contractor

NE SW

SECTION PLAT

330


Ft. from N. Line

Ft. from S. Line

330

Ft. from E. Line

Ft. from W. Line

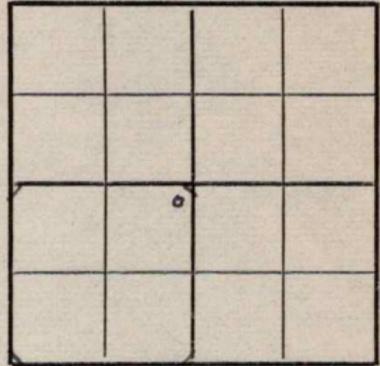

Russell Pool

RECORD

Location _____

Cased _____ in., _____ ft.

Rig up _____

Sand _____

Drilling and Remarks:

Gas _____

Cable rig

Oil _____

Total Depth _____

PRODUCTION

1st 24 hrs. Nat. _____

1st 24 hrs. after shot _____

Gas _____ Cu. Ft.

Dry Hole _____

Abandoned _____

Date

DEC 22 1943

19

S. J. LEWIS Scout

KANSAS

Map No. 12 Sec. 34 Twp. 13 R. 14W

Well No. 1 Bertha Wolf

Black-Marshall Company

COMPLETED Contractor

NE SW


SECTION PLAT

330 Ft. from N. Line

_____ Ft. from S. Line

330 Ft. from E. Line

_____ Ft. from W. Line

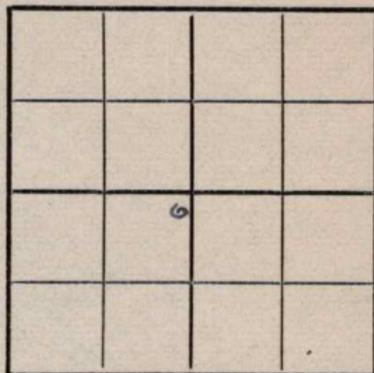

Russell Pool

Location _____

Rig up _____

Drilling and Remarks:

Iron can 3288

5" @ 3290

Pump 50 P.S.

36 3/4

RECORD

Cased _____ in., _____ ft.

Sand _____

Gas _____

Oil _____

Total Depth 3294

PRODUCTION

1st 24 hrs. Nat. _____

1st 24 hrs. after shot _____

Gas _____ Cu. Ft.

Dry Hole _____

Abandoned _____

Date

MAR 29 1944 19

S. J. LEWIS Scout